


# T.36S.R.3W.W.M.

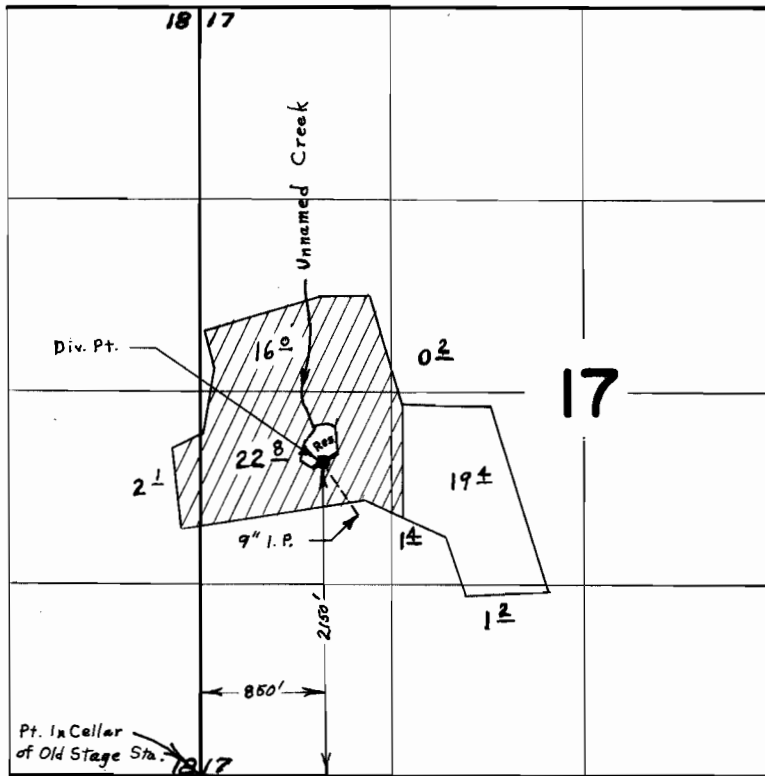

## FINAL PROOF SURVEY UNDER

R-37318                      R-2985  
Application No. 37319    Permit No. 28103  
IN NAME OF

DEL RIO ORCHARDS

Surveyed June 3 1966, by L. E. Gould