


T.36S.R.3W.W.M.

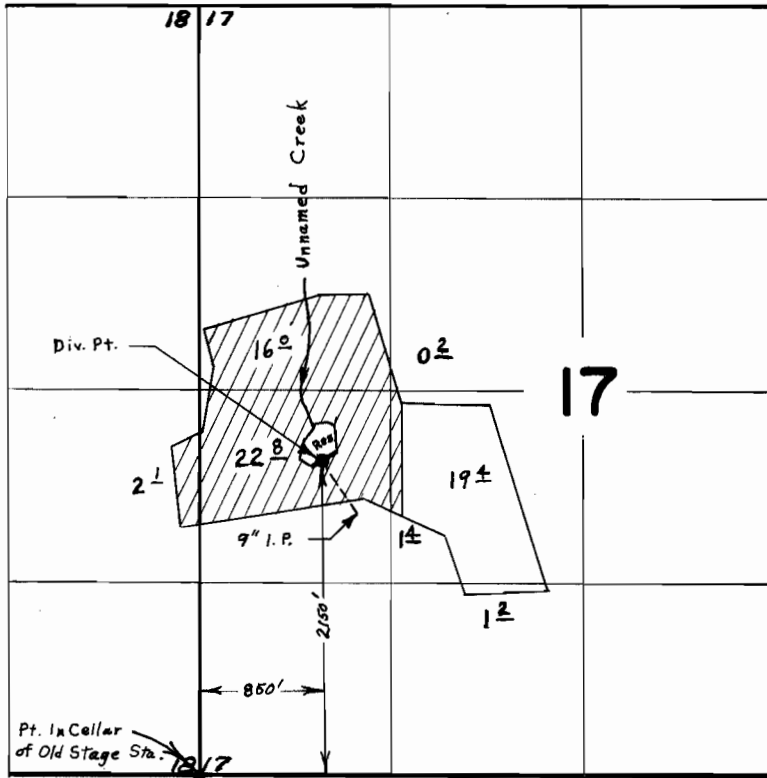

FINAL PROOF SURVEY UNDER

R-37318 R-2985
Application No. 37319 Permit No. 28103
IN NAME OF

DEL RIO ORCHARDS

Surveyed June 3, 1966, by L. E. Gould