
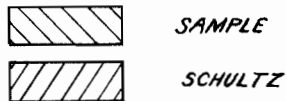


T.38S.R.3W.W.M.

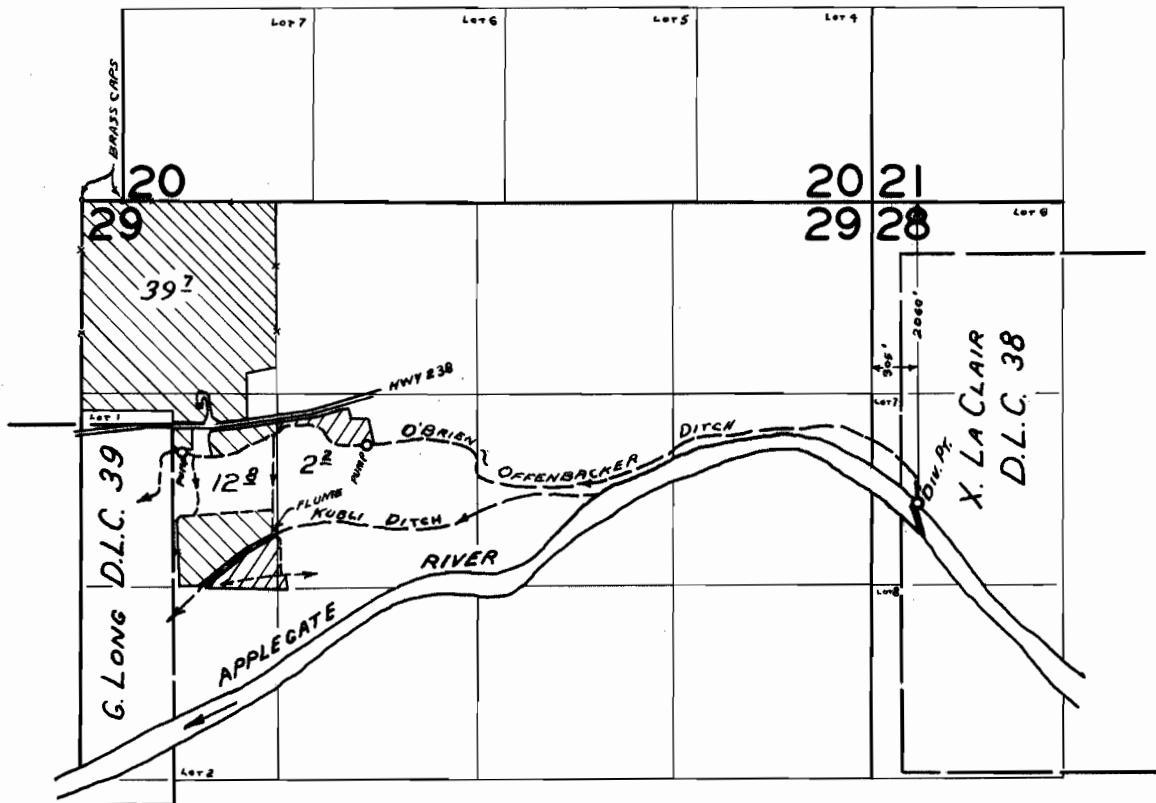

Note: Div. Pt. location taken from Application map

FINAL PROOF SURVEY
UNDER

Application No. 37272 Permit No. 28548
IN NAME OF
GLADYS SCHULTZ
& **GEORGE W. SAMPLE**

Surveyed JUN. 24, 1965, by C. GARDNER