


T. 35 & 36 S. R. 1 & 2 W. W.M

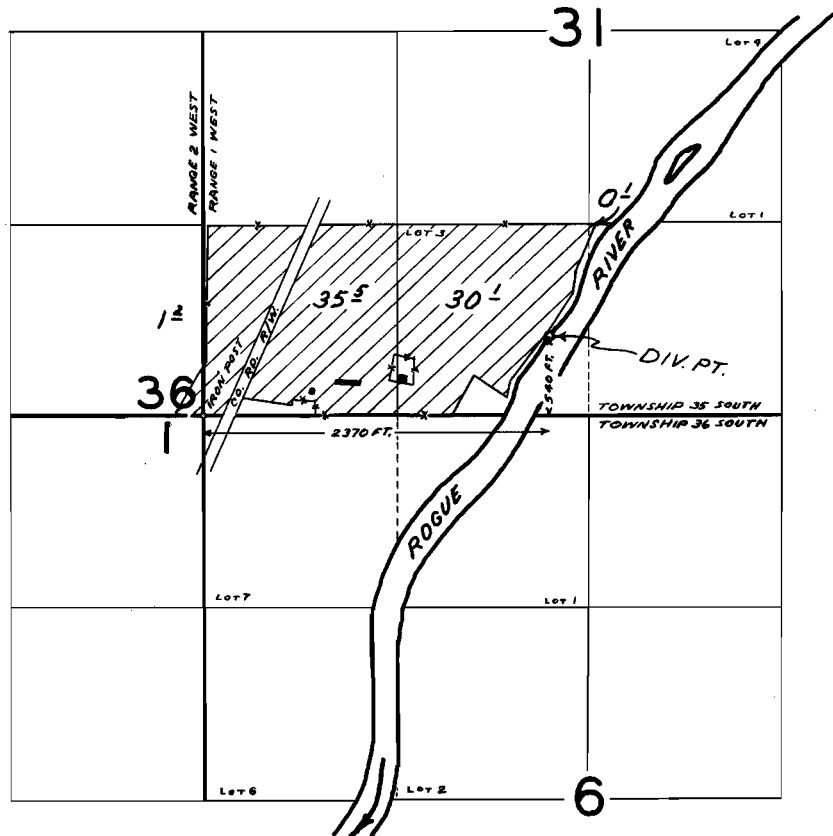

FINAL PROOF SURVEY
UNDER

Application No. 32939 Permit No. 26032
IN NAME OF

KENNETH & BARBARA H. TONER

Surveyed JUL 13 1965, by C. GARDNER