


T. 40S. R. 3W. W.M.

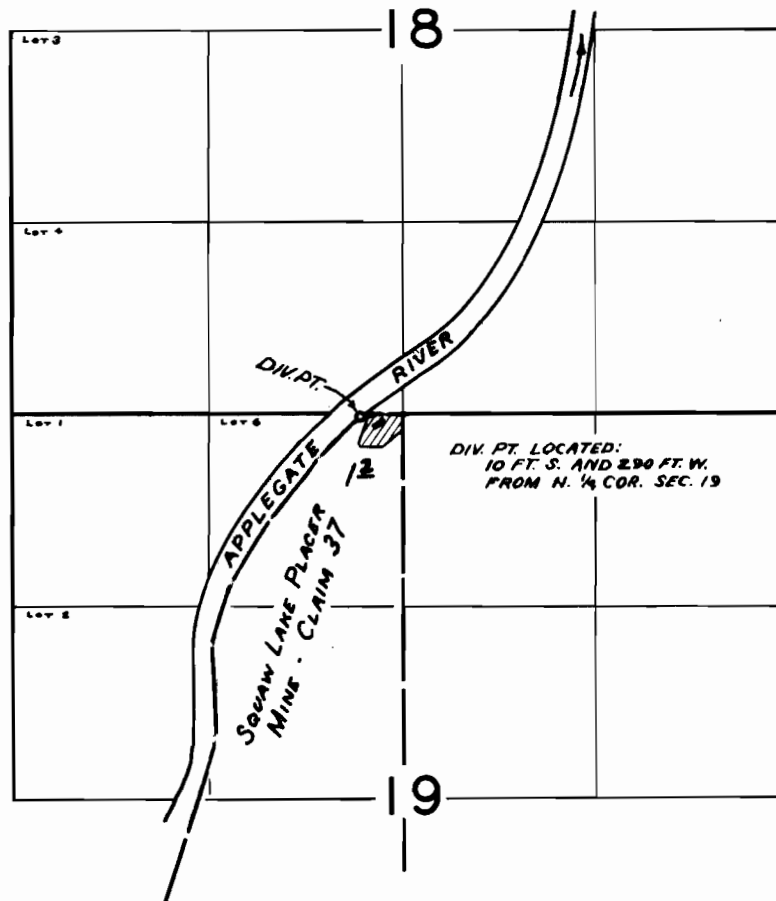

FINAL PROOF SURVEY
UNDER

Application No. 33912 Permit No. 26718
IN NAME OF

HELMUT TROST

Surveyed JUN 30 1965, by C. GARDNER