




T.36 S.R.3 W.W.M.

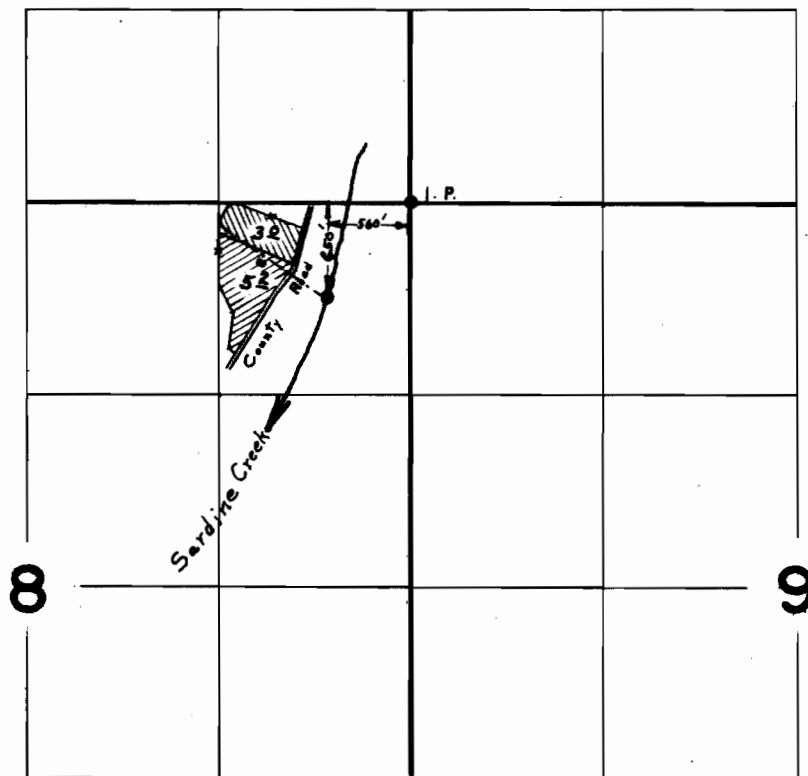

 Supplemental
 Primary

FINAL PROOF SURVEY
UNDER

Application No. 33246 Permit No. 26339
IN NAME OF

THELBERT WRIGHT

Surveyed June 10 1966, by R. E. Gould