


T.39S.R.5W.W.M.

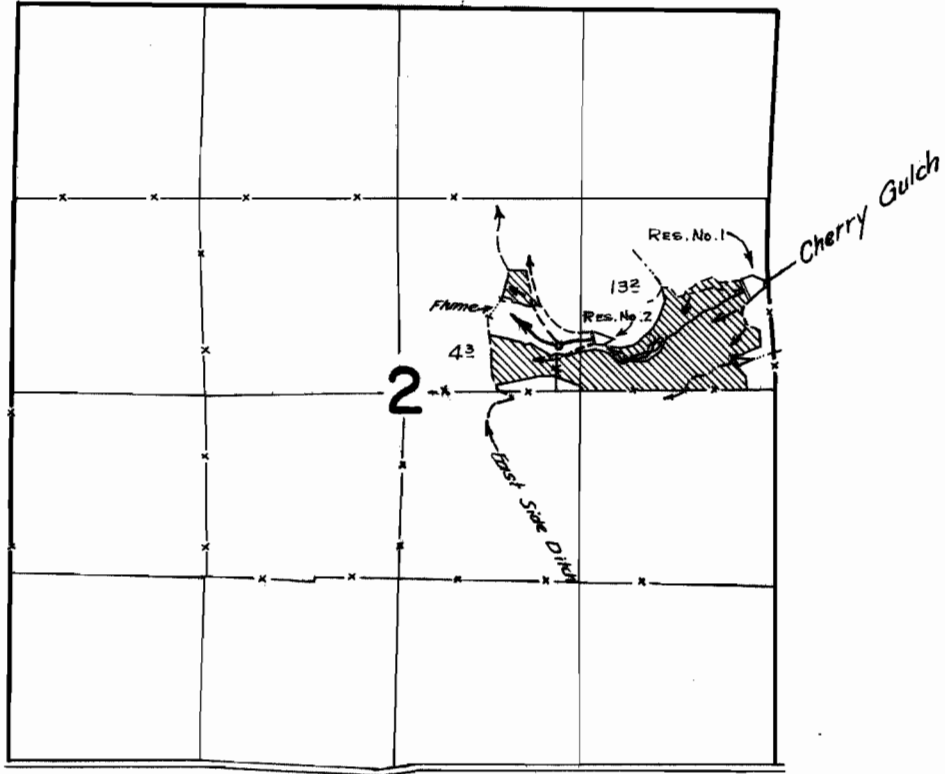

FINAL PROOF SURVEY
UNDER

R-37254 R-2864
Application No. 37255... Permit No. 27926...
IN NAME OF

CLAIRE O. BROWN

Surveyed July 1, 1965, by *R. Jackson*