



ATTACHMENT FOR PERMIT
TO APPROPRIATE THE PUBLIC
WATERS OF THE STATE OF OREGON

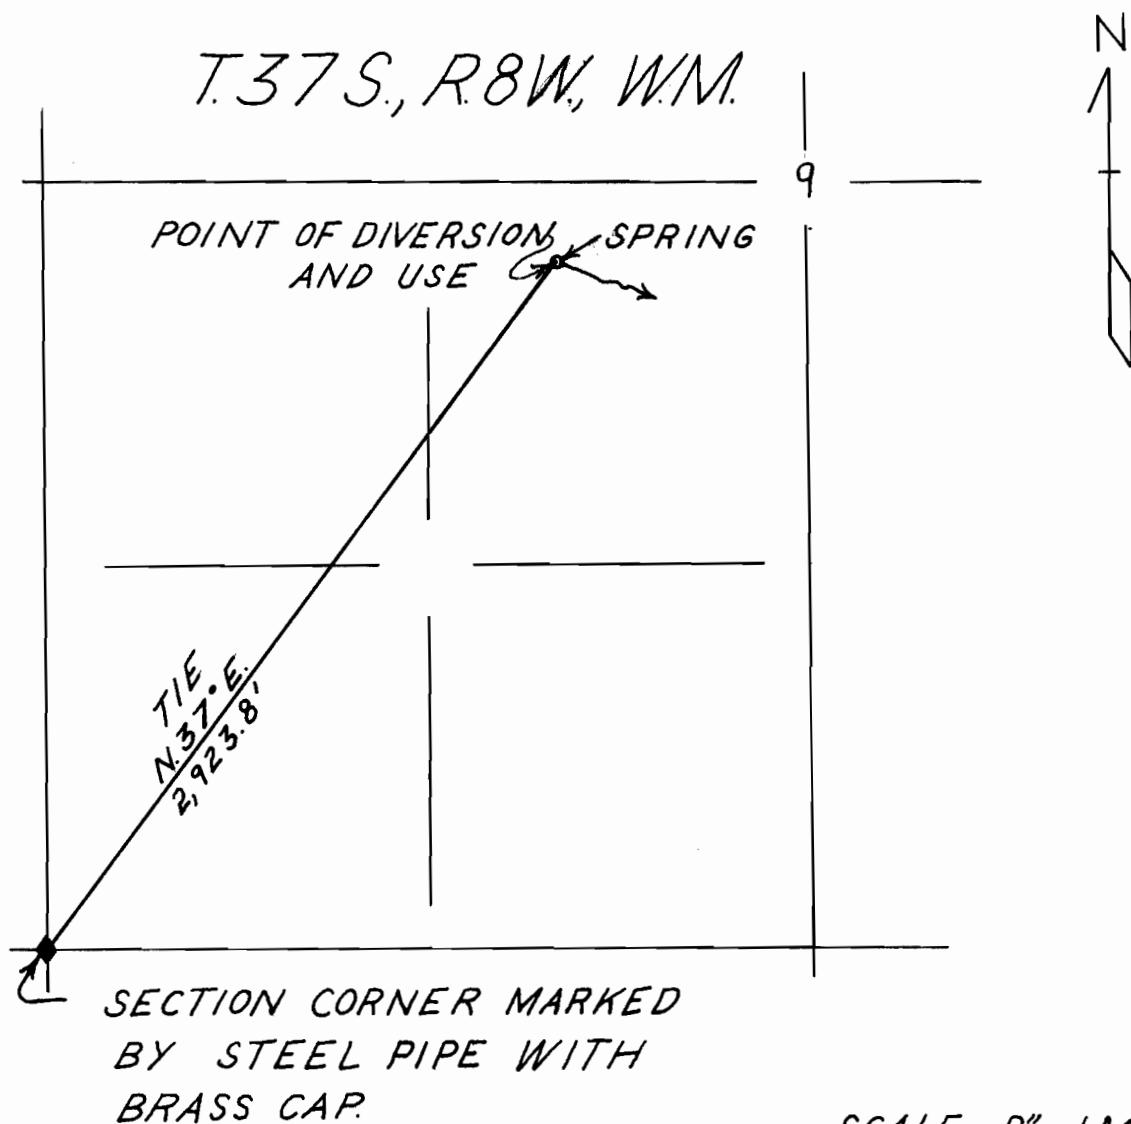

Application No. 39481
Permit No. 29828

SCALE - 8" = 1 MILE
DATE - 1/16/64
Map 1 of 2

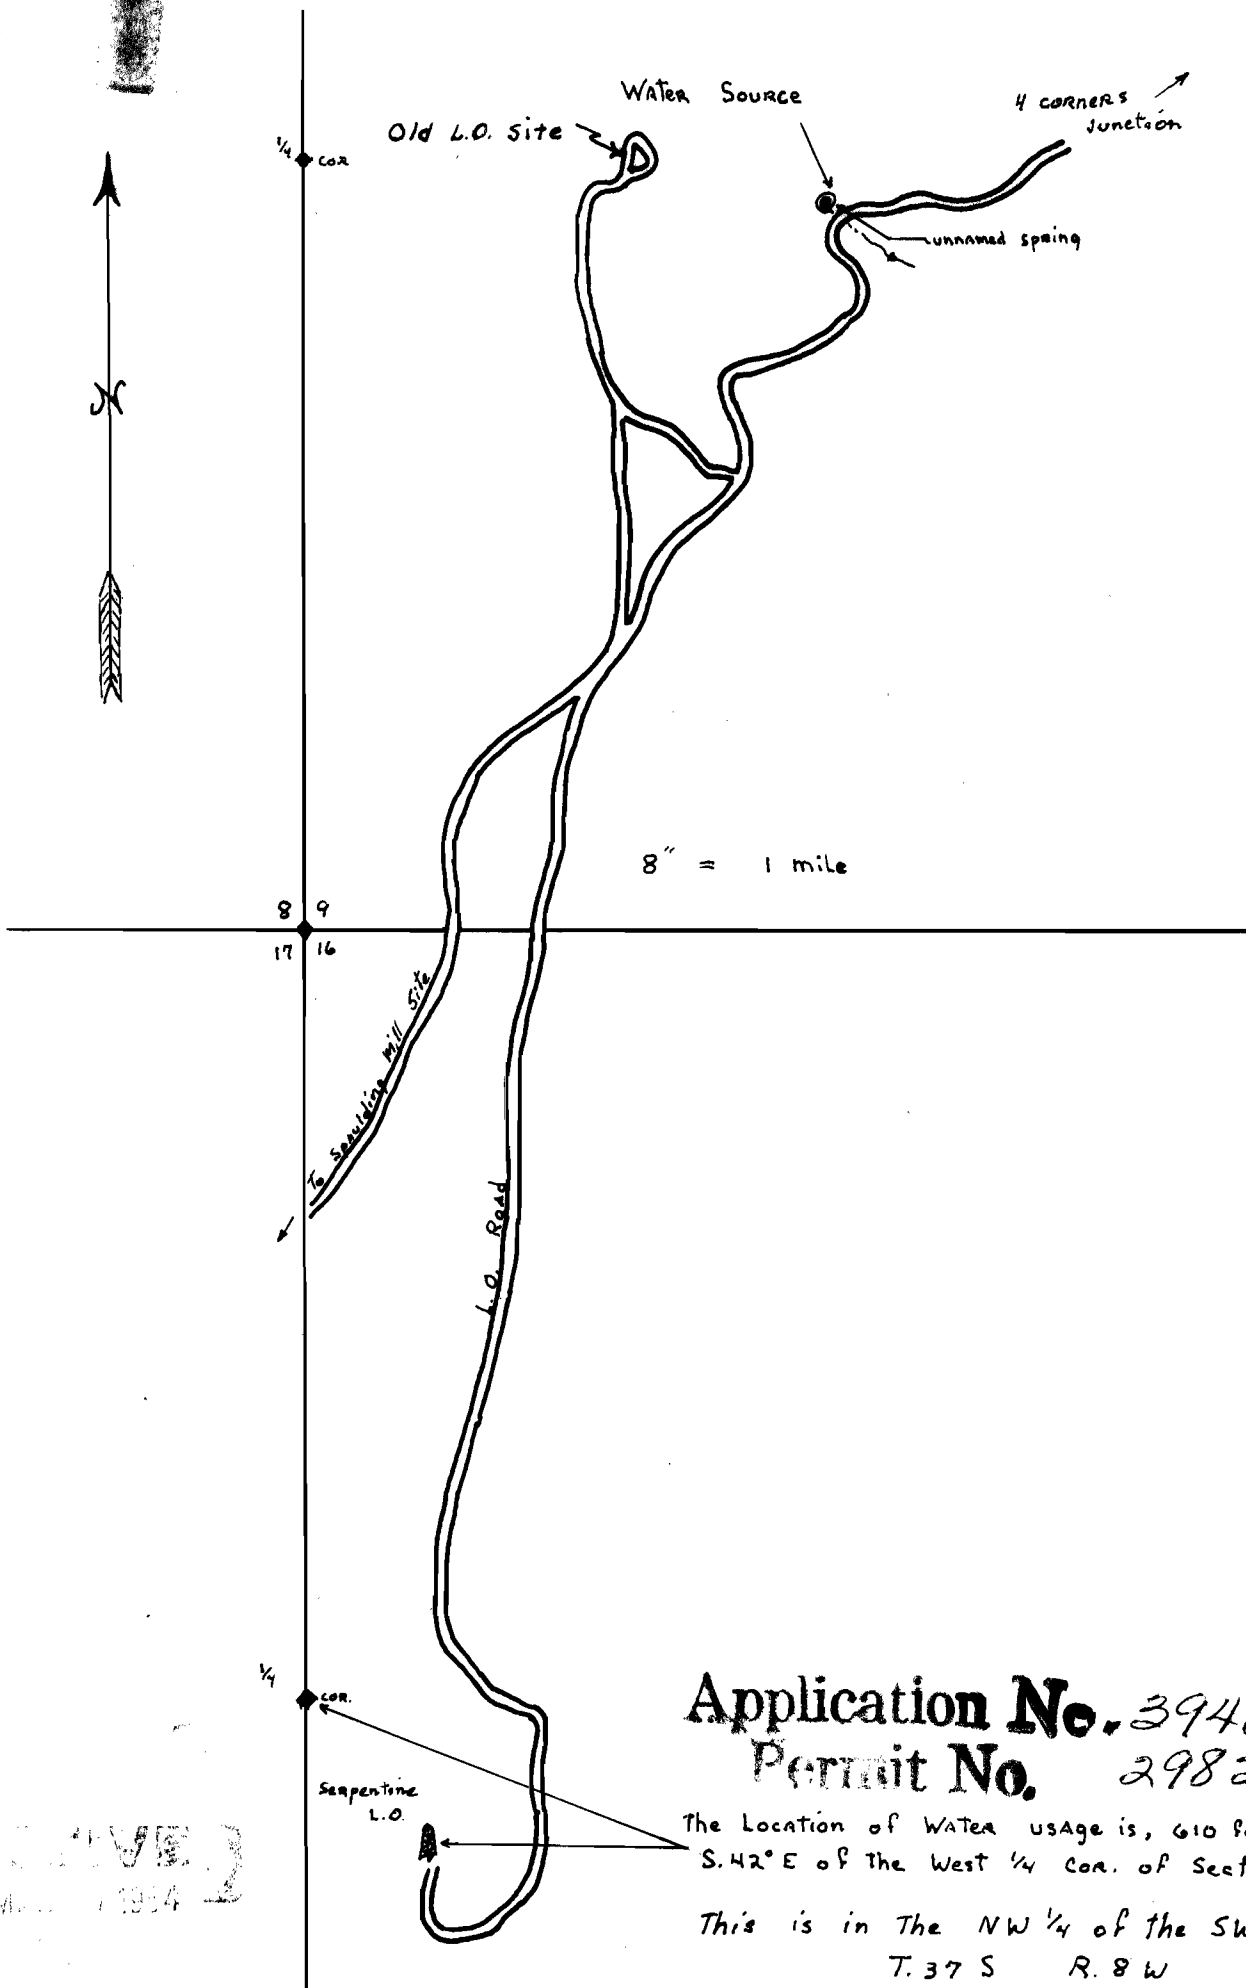

Application No. 39481
Permit No. 29828

The Location of Water Usage is, 610 feet
 S. 42° E of the West 1/4 cor. of Section 16

This is in the NW 1/4 of the SW 1/4 of Sec. 16.
 T. 37 S R. 8 W