
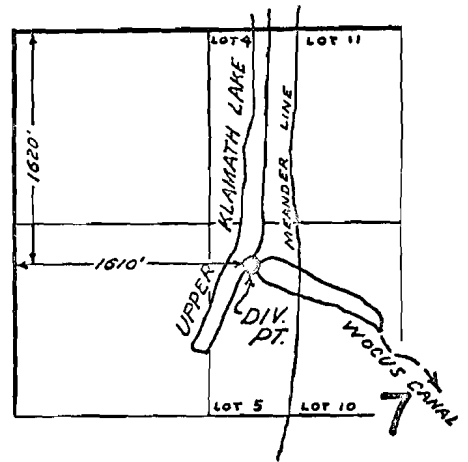


# T.38S.R.8E.W.M.

Upper Klamath Lake Meas.

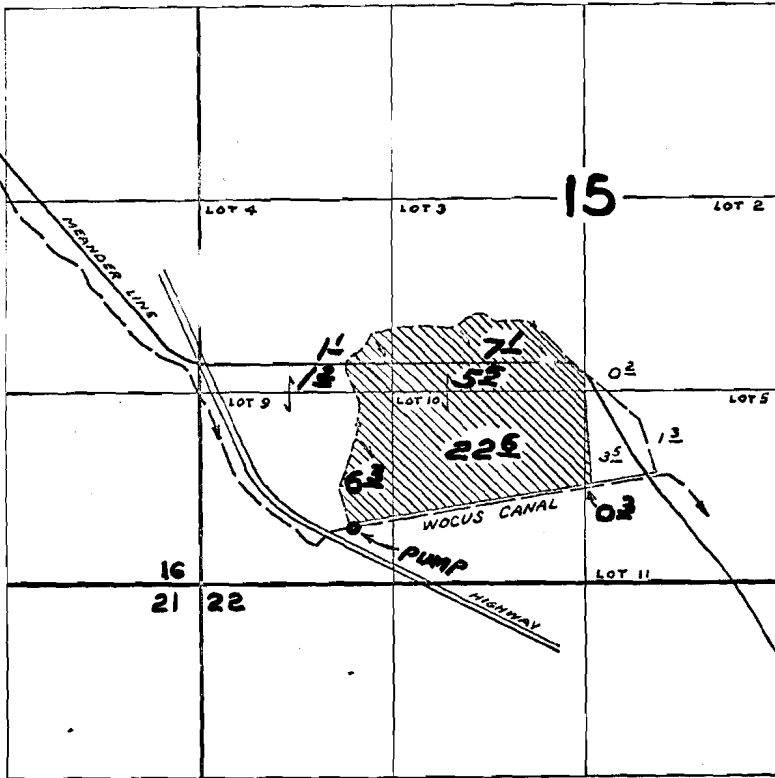

## FINAL PROOF SURVEY UNDER

Application No. 33676 Permit No. 26734  
IN NAME OF

ROLAND W. GEARY

Surveyed SEP. 28, 1965, by R. JACKSON