



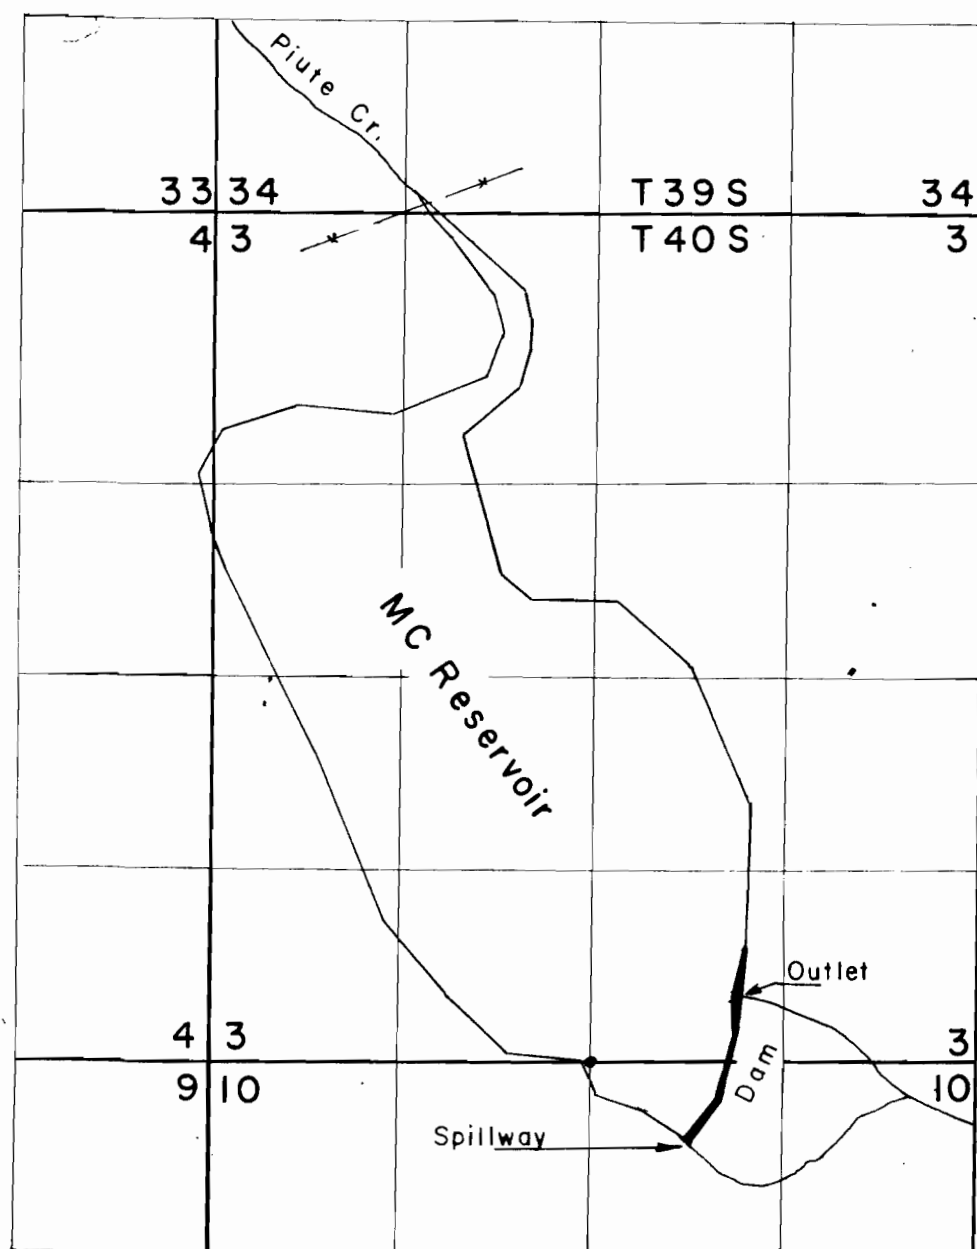

T.39 & 40S.R.26E.W.M.

T.40S.R.27E.W.M.

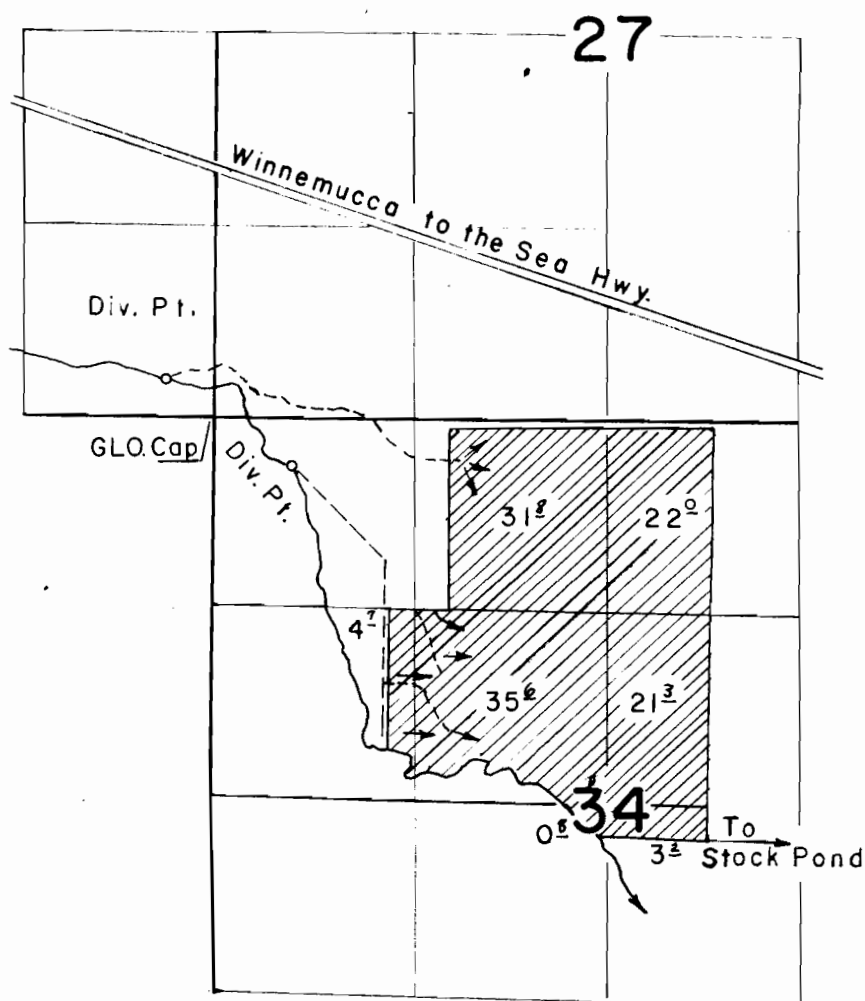

FINAL PROOF SURVEY

UNDER

Application No. R 15154 Permit No. R 666
15155 11041

IN NAME OF

WARNER VALLEY STOCK CO.

Surveyed Sept. 9 1964 by C.J.Gardner