


T.40 S.R.27 E.W.M.

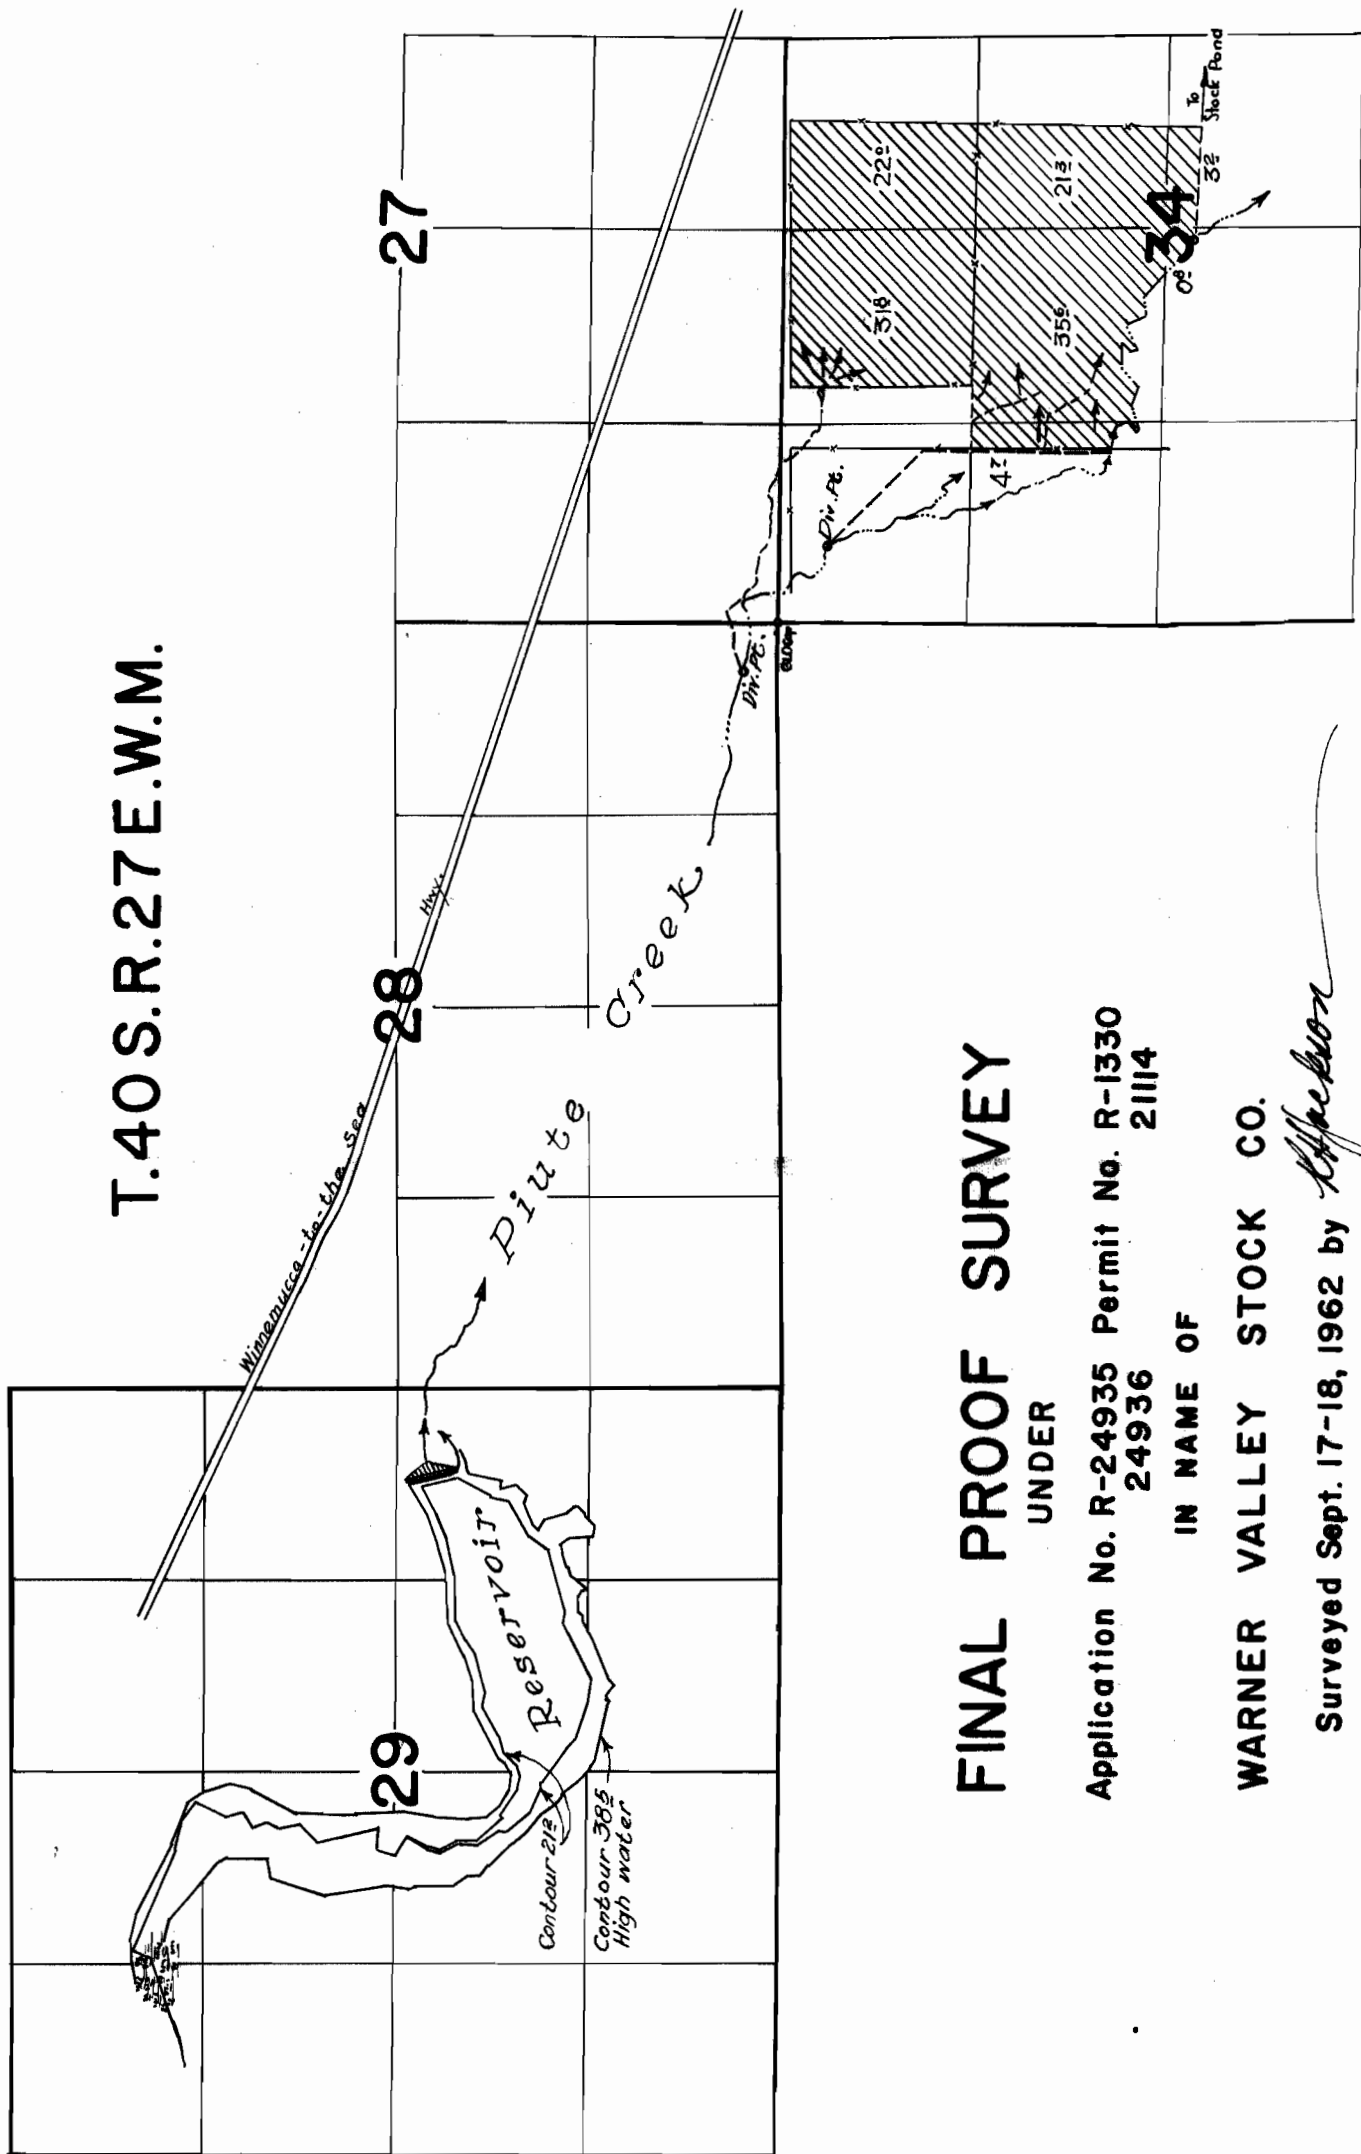

FINAL PROOF SURVEY

UNDER

Application No. R-24935 Permit No. R-1330
24936 21114

IN NAME OF

WARNER VALLEY STOCK CO.

Surveyed Sept. 17-18, 1962 by

H. Jackson