


T.17S.R.6W.W.M.

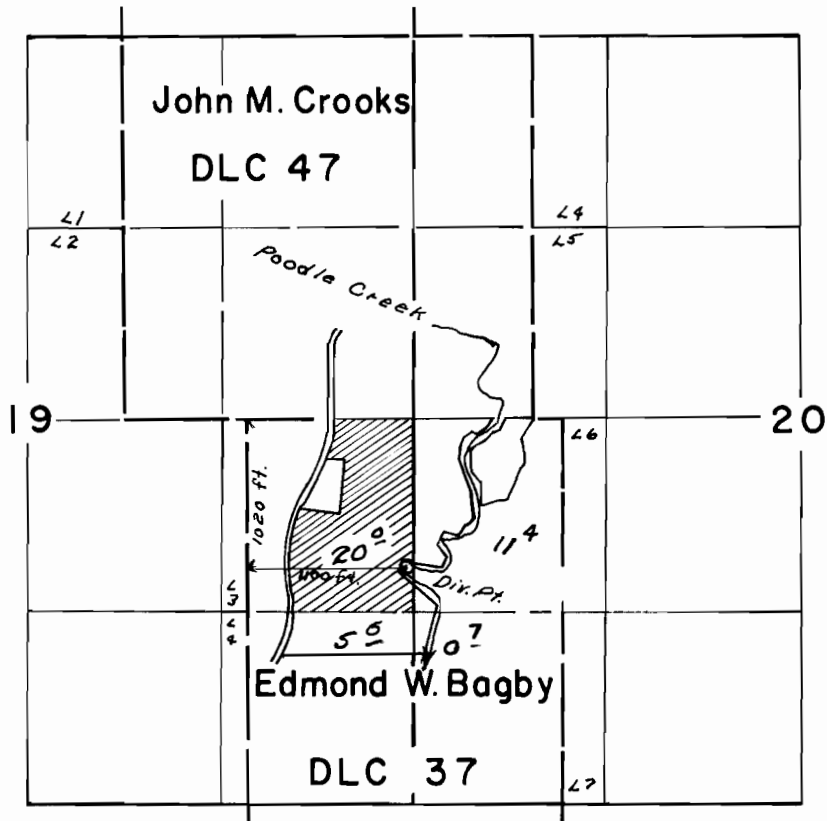

FINAL PROOF SURVEY
UNDER

Application No. 35061 Permit No. 27449

IN NAME OF
ERNEST & ALVA CROFTON and
GEORGE & EVELYN CROFTON

Surveyed April 28, 1965, by *Clayton*