


T.17S. R.6W. W.M.

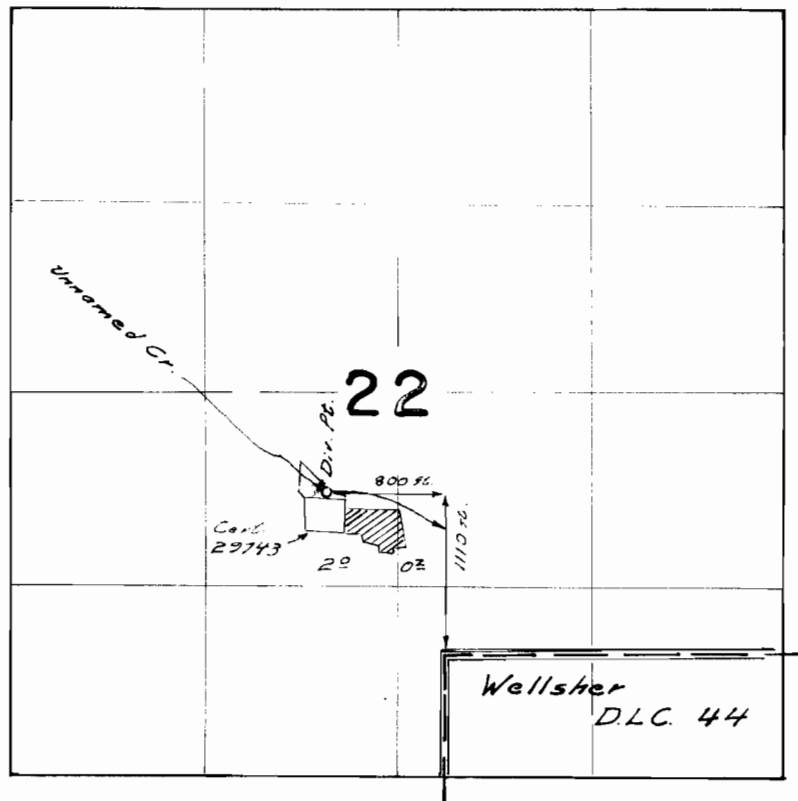

FINAL PROOF SURVEY
UNDER

Application No. *38154* Permit No. *28444*
IN NAME OF

HAROLD W. & HAZEL LIVINGSTON

Surveyed *March 31 1967*, by *W. J. Ruppert*