


T.20S.R.3W.W.M.

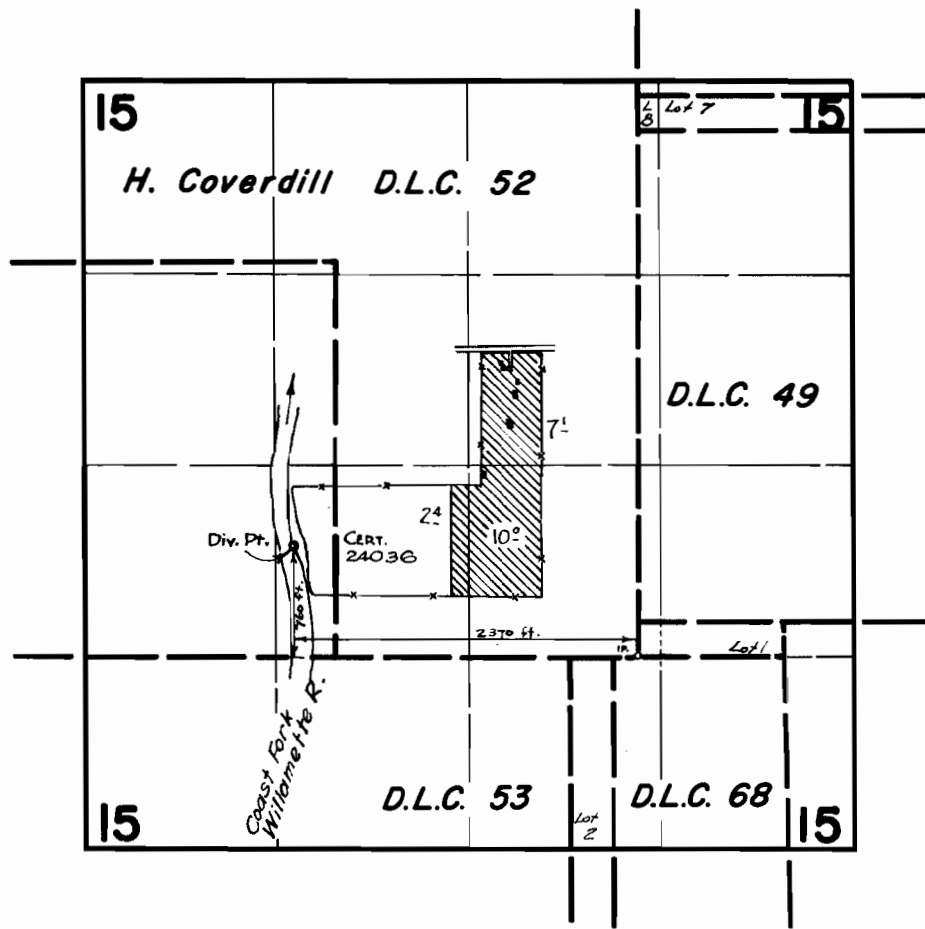

FINAL PROOF SURVEY
UNDER

Application No. **38701** Permit No. **28818**
IN NAME OF

PAUL W. MEYERS

Surveyed *April 29* 1965, by *St. Johnson*