


T. 16 S. R. 2 W. W. M.

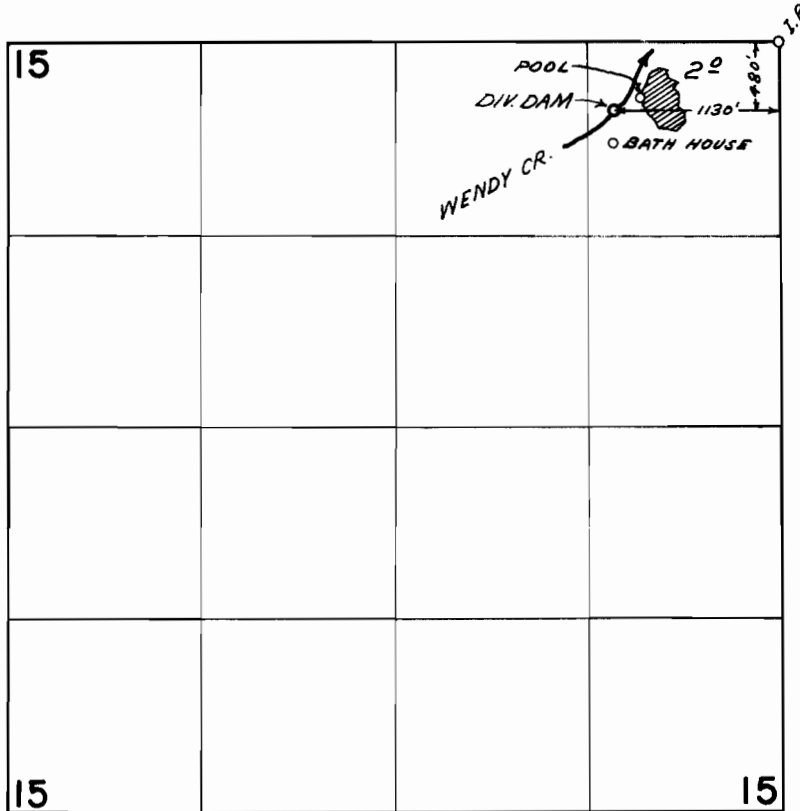

**FINAL PROOF SURVEY**  
UNDER

Application No. 34630 Permit No. 27250  
IN NAME OF

WILLAMETTANS INCORPORATED

Surveyed May 7, 1965, by Clayton J. Gardner