


T.14S.R.3W.W.M.

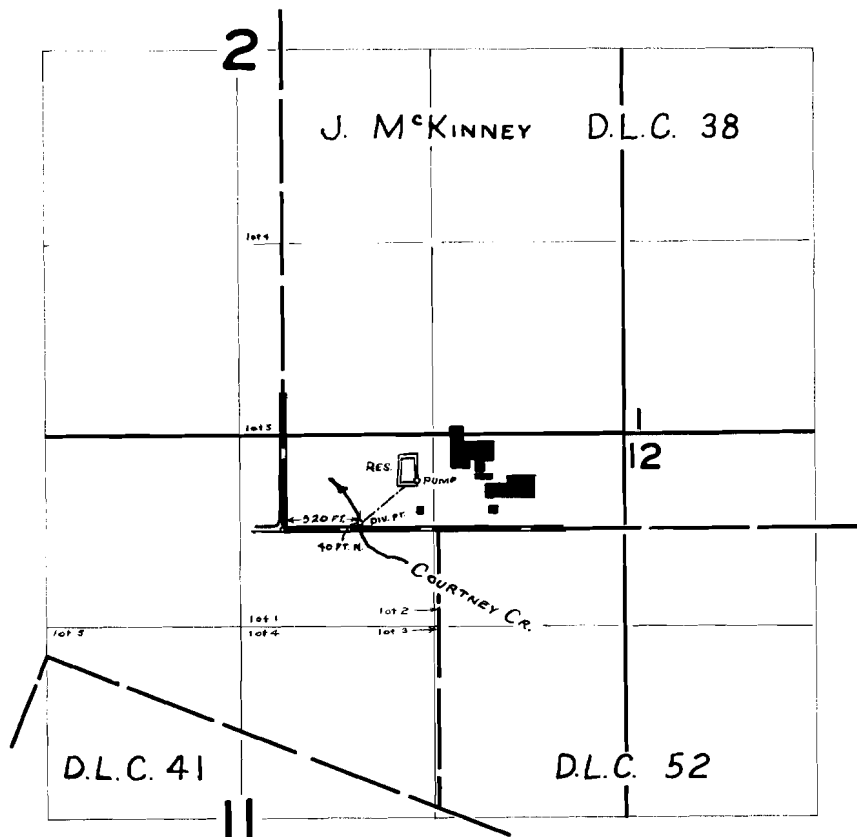

FINAL PROOF SURVEY

UNDER

Application No. R-40110 Permit No. R-4465
40111 29905
IN NAME OF _____

BROWNSVILLE PARTICLE BOARD, INC.

Surveyed SEP. 20 1965, by R. JACSON