


T.14 S. R. I. W. W. M.

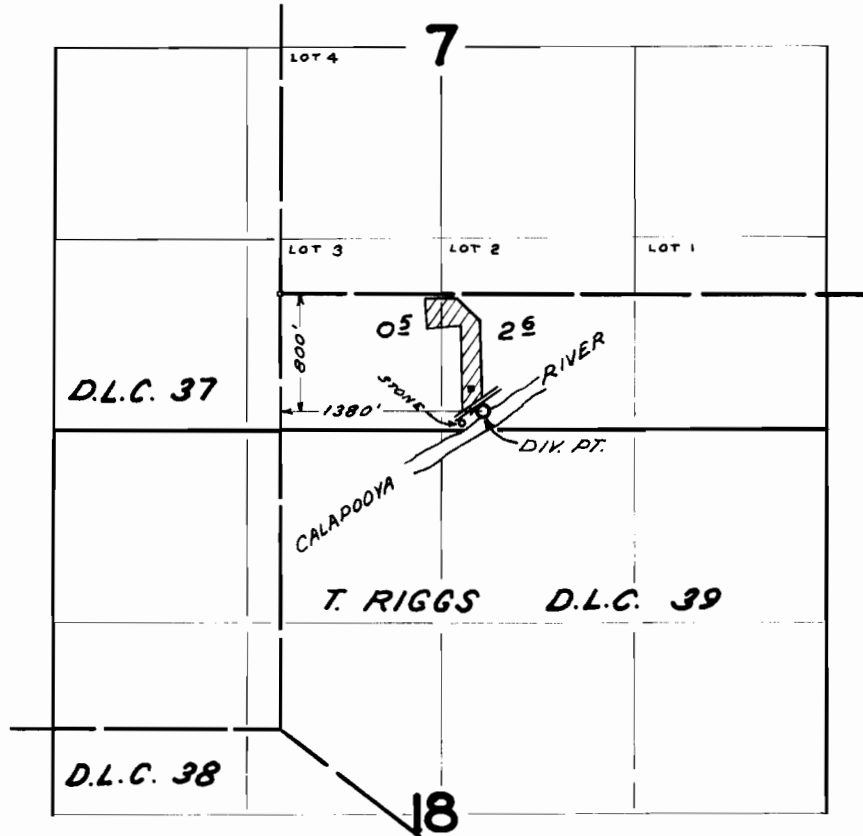

FINAL PROOF SURVEY UNDER

Application No. 37105 Permit No. 27619
IN NAME OF

SELMER & PHYLLIS FOLLESVOLD

Surveyed Oct. 14, 1965, by R. JACKSON