


T. 13 & 14 S. R. 2 W. W. M.

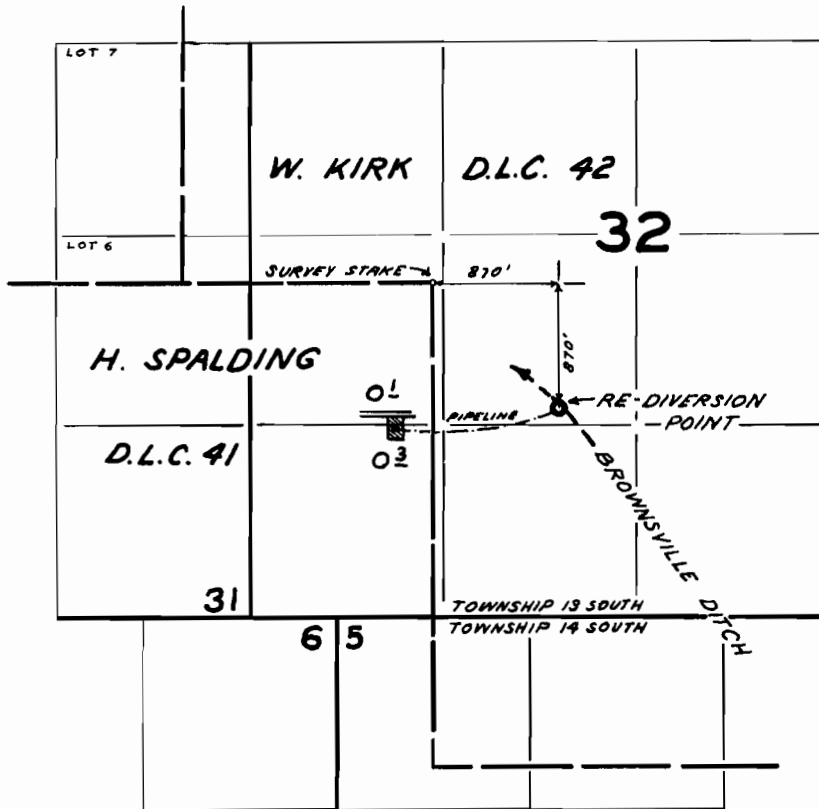

FINAL PROOF SURVEY  
UNDER

Application No. 39566 Permit No. 29515  
IN NAME OF

ETHEL L. NAYLOR

Surveyed SEP. 20, 1965, by R. JACKSON