


T.9S.R.2E.W.M.

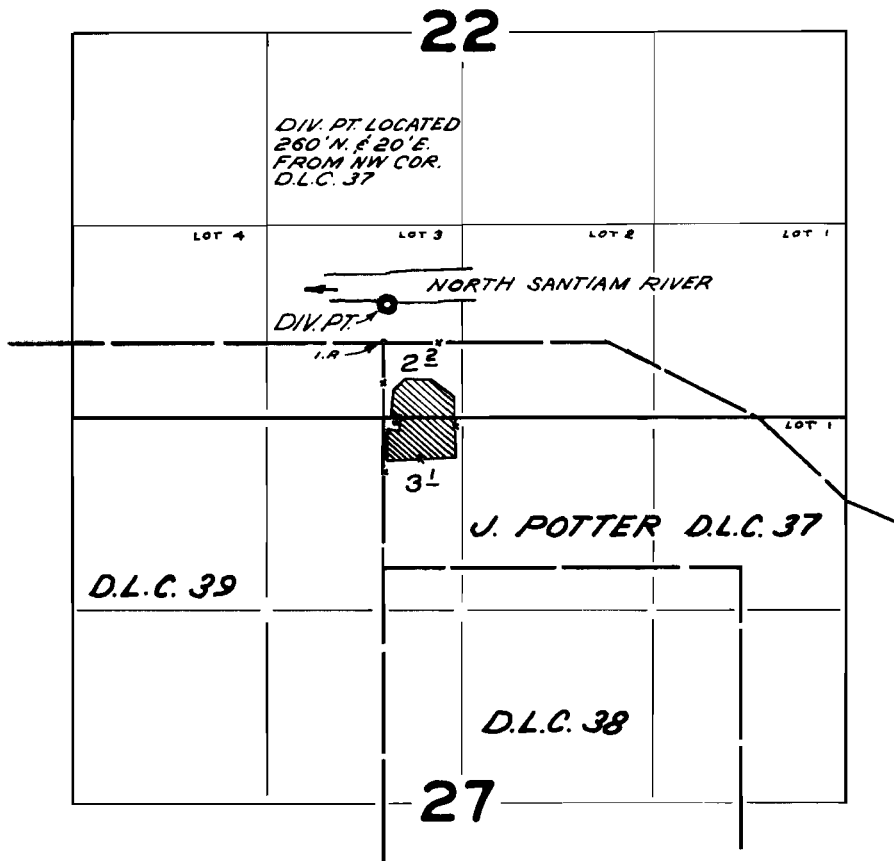

FINAL PROOF SURVEY UNDER

Application No. 37572 Permit No. 27991

IN NAME OF

MARVIN AND JACQUELYNN WALKER

Surveyed Oct 15, 1965, by R. JACKSON