


T.30S.R.46E.W.M.

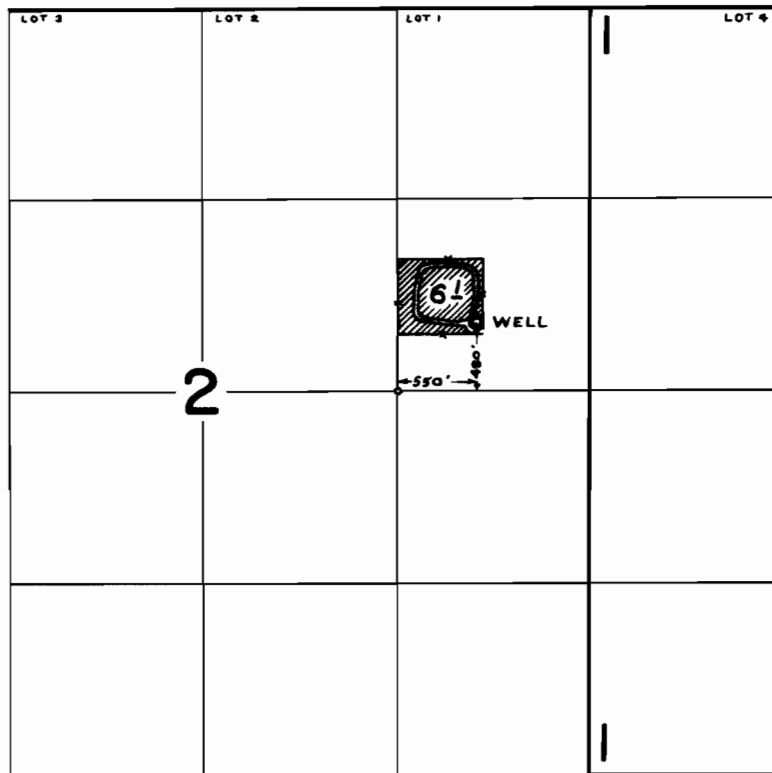

FINAL PROOF SURVEY
UNDER

Application No. G-829 Permit No. G-733
IN NAME OF
Jordan Valley
Cemetery Maintenance District

Surveyed Oct. 13 1965, by C. GARDNER