


T. 18 S. R. 46 E. W. M.

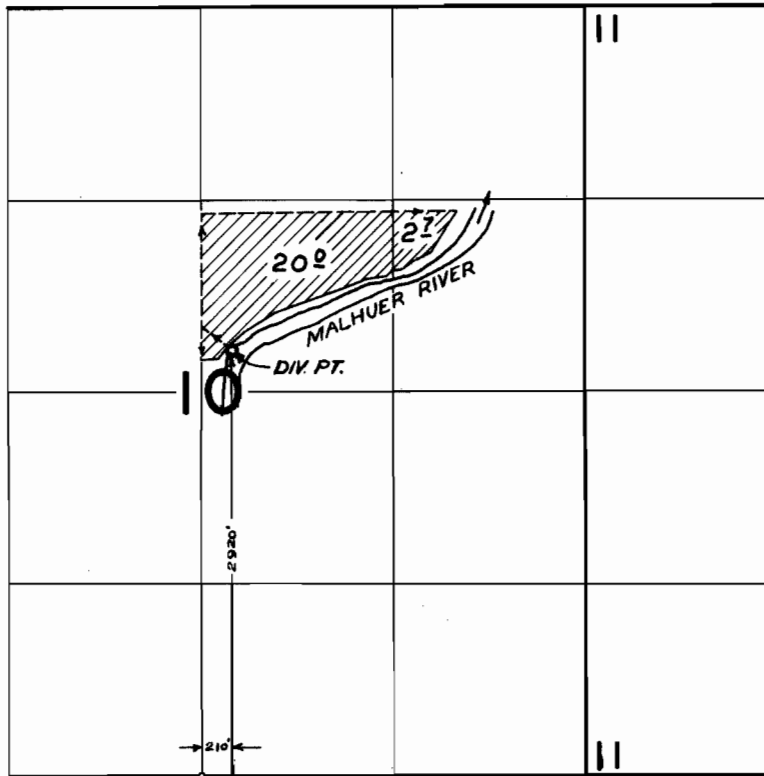

FINAL PROOF SURVEY UNDER

Application No. 38686 Permit No. 28816
IN NAME OF

Hugh R. and Lorraine E. Lackey

Surveyed Oct 9 1965, by C. GARDNER