


T.5S.R.2W.W.M.

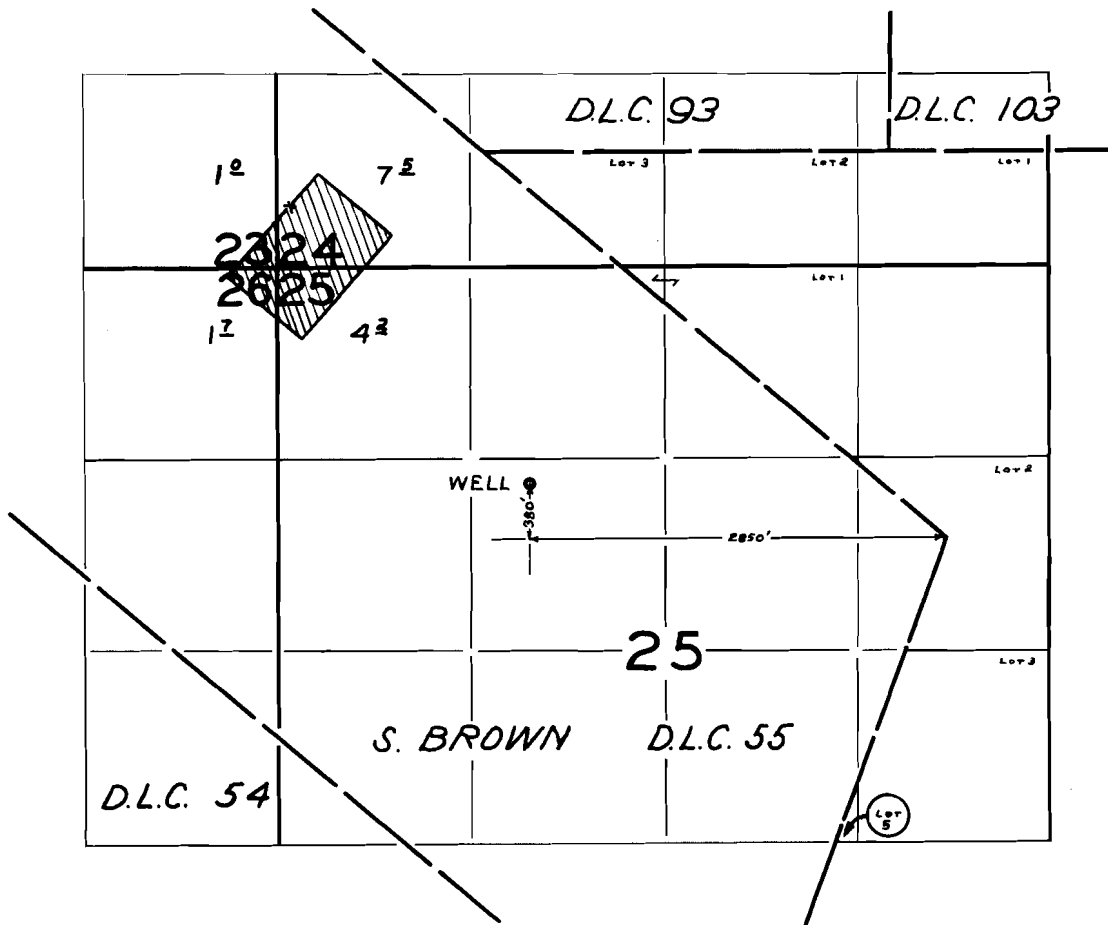

FINAL PROOF SURVEY
UNDER

Application No. G-2787 Permit No. G-2598
IN NAME OF

PHILIP V. BERNING

Surveyed MAY 14 1965, by C. GARDNER