


T.5S.R.2W.W.M.

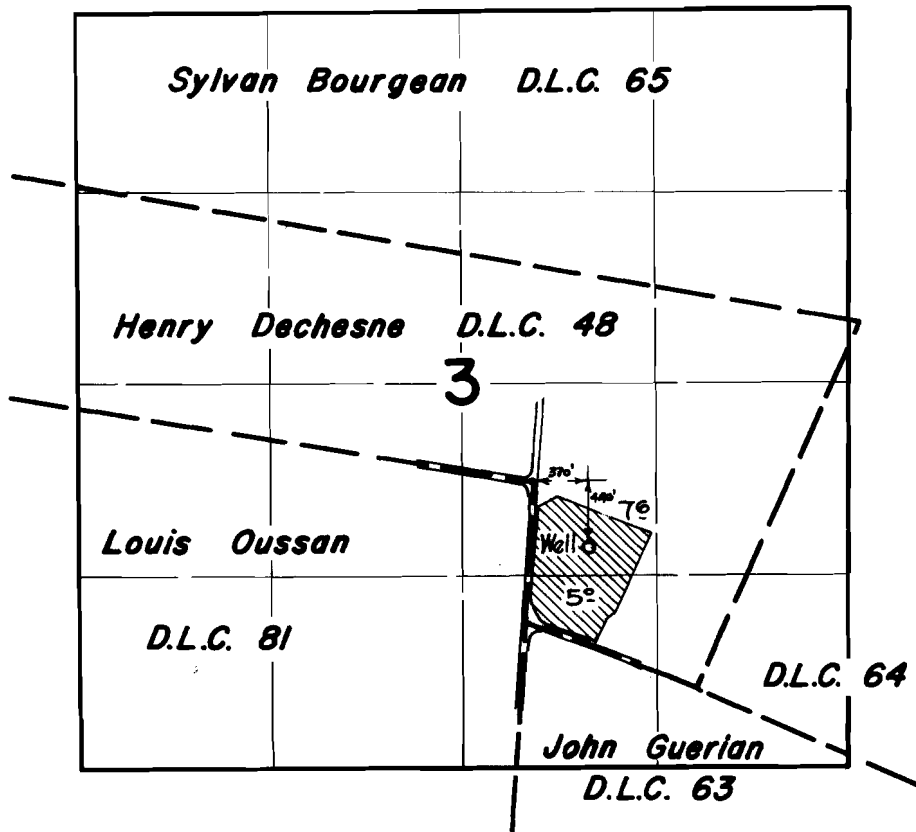

FINAL PROOF SURVEY UNDER

Application No. G-2139 Permit No. G-1988
IN NAME OF

ROBERT G. BROWN

Surveyed *June 3* 1965. by *[Signature]*