


T.4S.R.3W.W.M.

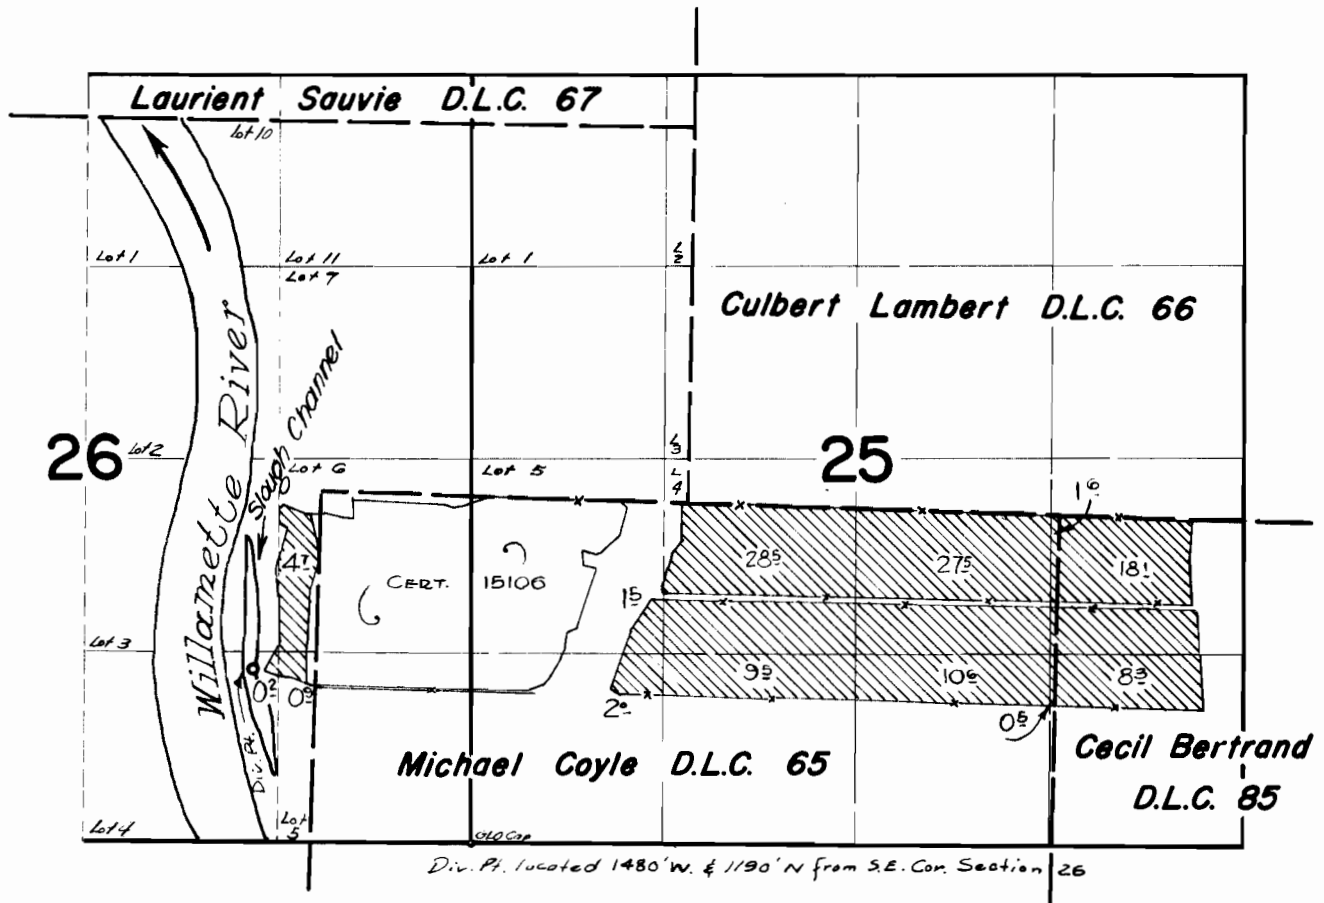

FINAL PROOF SURVEY
UNDER

Application No. 37629 ... Permit No. 28058 ...
IN NAME OF

C. H. COYLE

Surveyed June 2, 1905. by *[Signature]*