


# T.8S.R.3W.W.M.

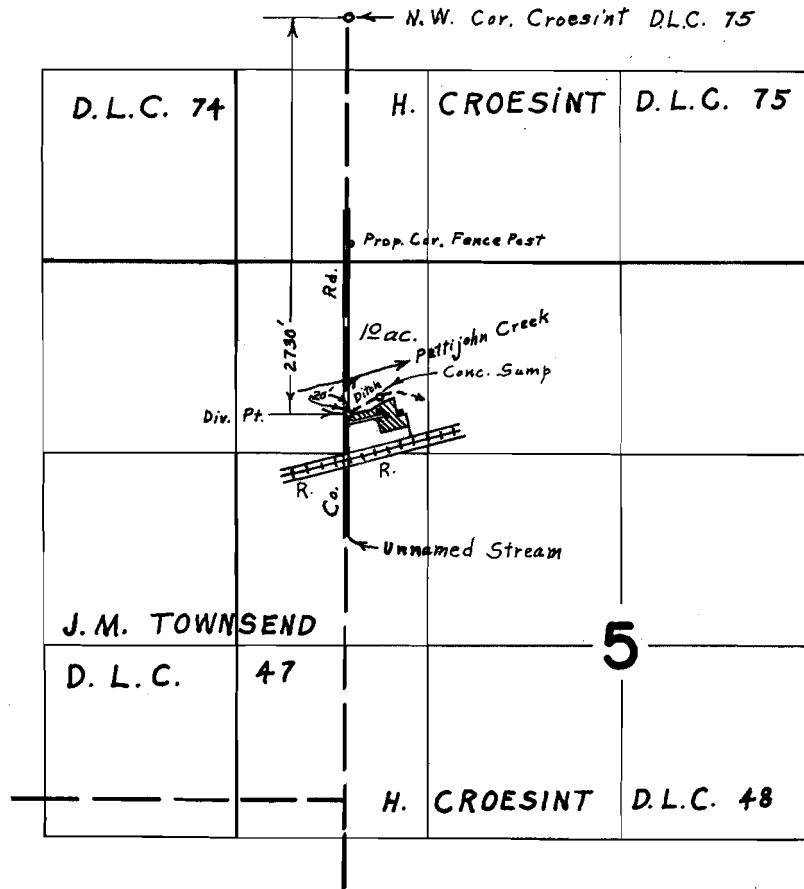

## FINAL PROOF SURVEY UNDER

Application No. 40205 Permit No. 29991  
IN NAME OF

**E. N. & MARY GRAVES**

Surveyed Sept. 6, 1966, by L. E. Gould  
Mar. 31 1967