


T6S.R.2 W.W.M.

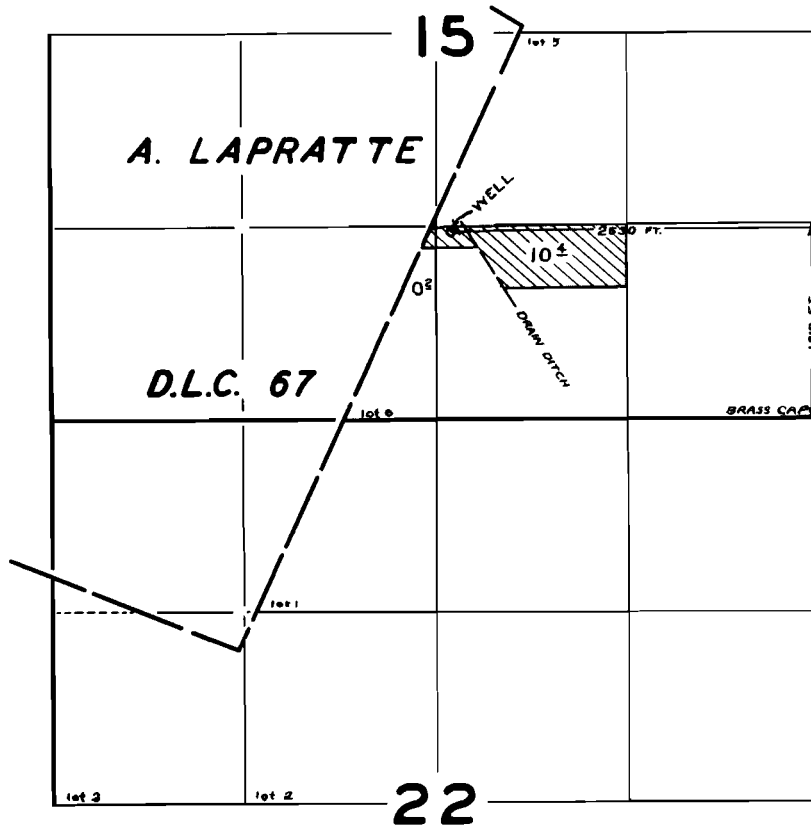

FINAL PROOF SURVEY
UNDER

Application No. G-2940 Permit No. G-2735
IN NAME OF

RUTH H. HARRIS

Surveyed JUL 9 1965, by L. COLEBANK