


T. 9 S. R. 1 E. W. M.

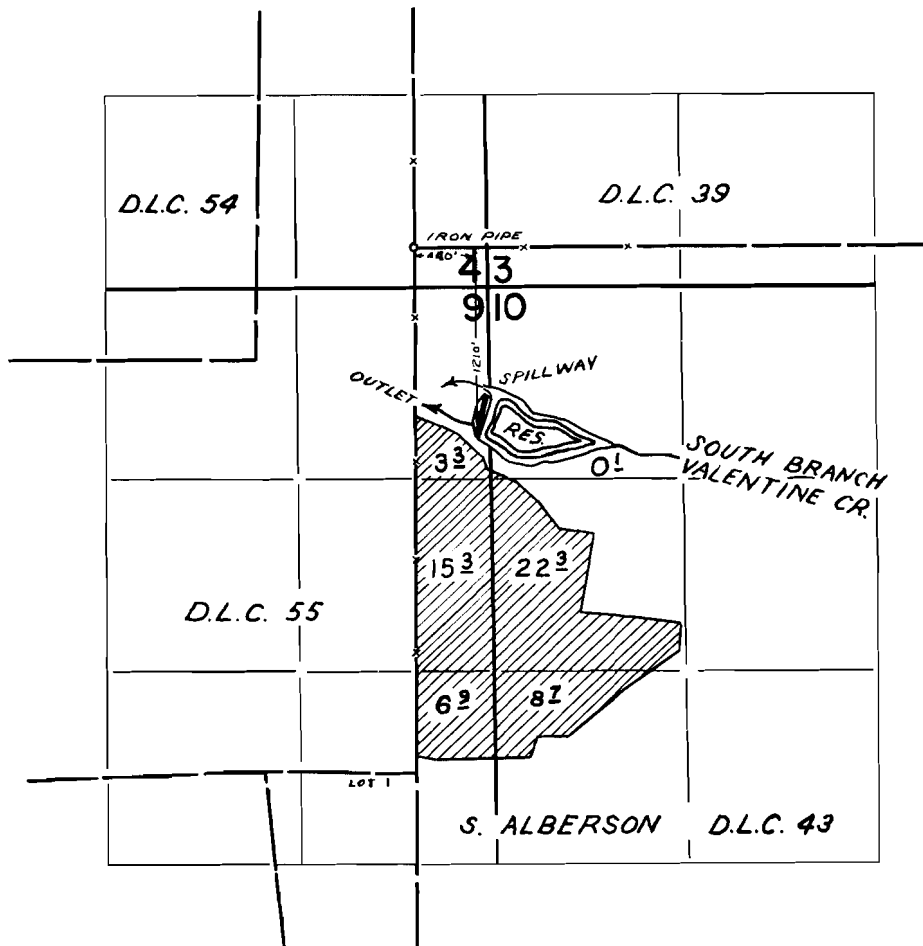

FINAL PROOF SURVEY UNDER

Application No. R-33442 Permit No. R-2301
33443 26456
IN NAME OF

Douglas Heater

Surveyed JUL 8 1965, by C. GARDNER