


T.9S.R.1E.W.M.

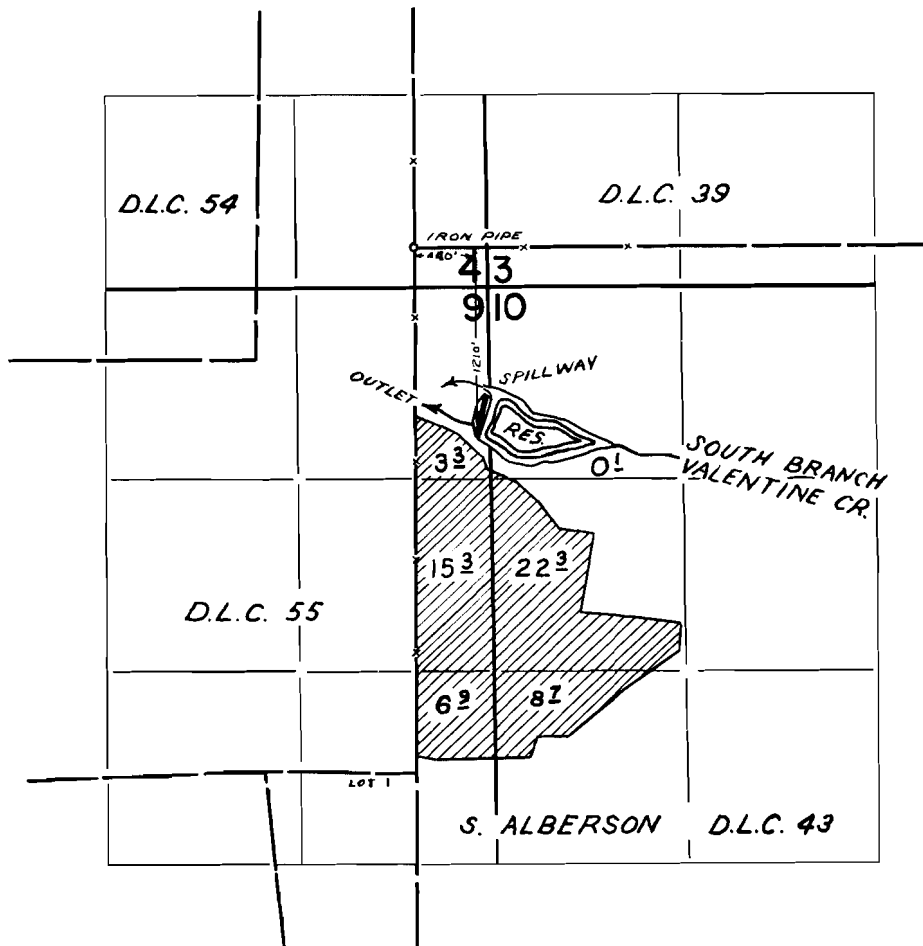

FINAL PROOF SURVEY  
UNDER

Application No. R-33442 Permit No. R-2301  
33443 26456  
IN NAME OF

Douglas Heater

Surveyed JUL 8 1965, by C. GARDNER