


# T.6S.R.2W.W.M.

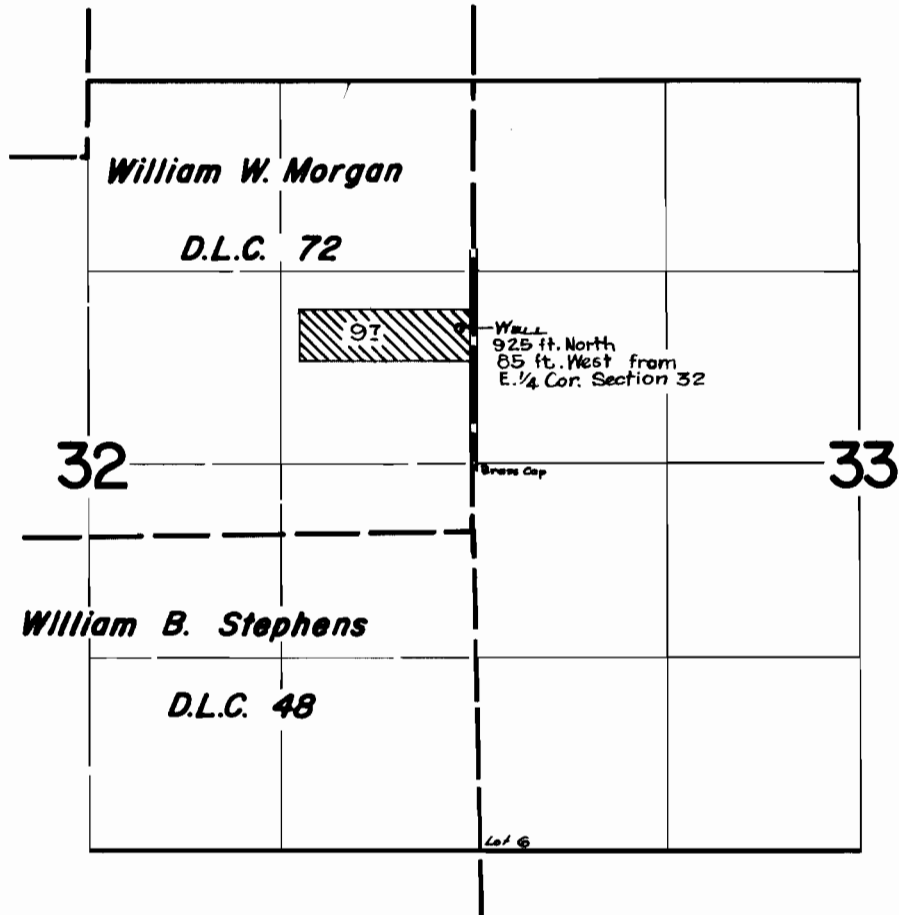

## FINAL PROOF SURVEY UNDER

Application No. G-2429 Permit No. G-2239  
IN NAME OF

A. J. LeMay

Surveyed June 4, 1965, by [Signature]