


T.5S.R.2W.W.M.

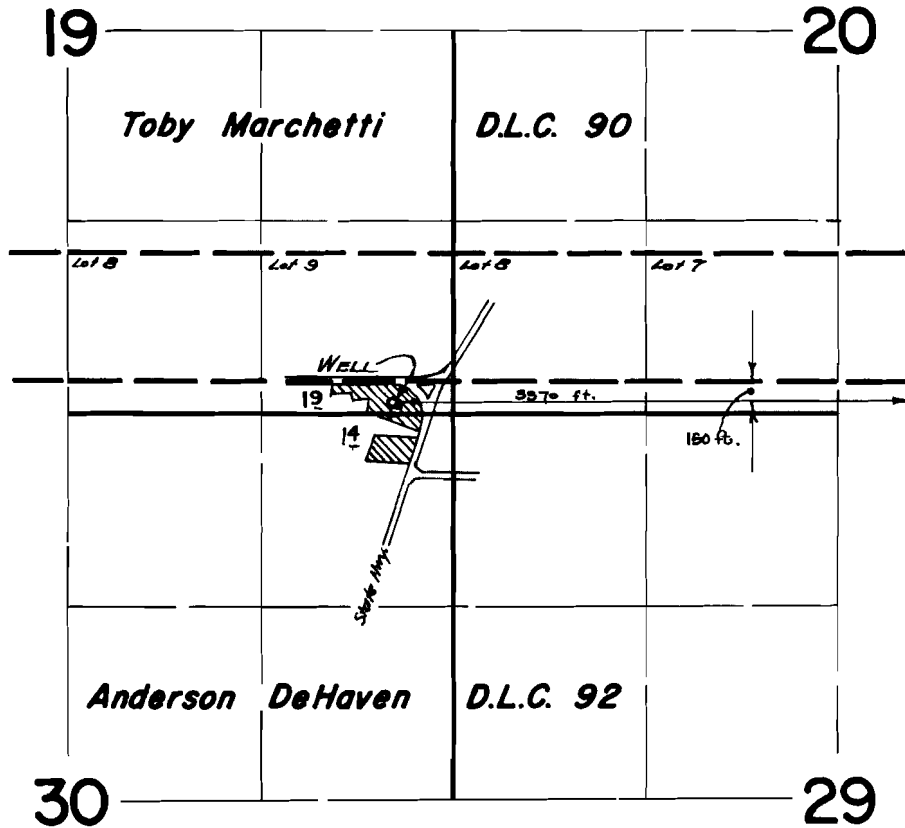

FINAL PROOF SURVEY
UNDER

Application No. G-2132 Permit No. G-1969
IN NAME OF

DONALD ALLYN NUSOM

Surveyed June 3, 1965, by [Signature]