


T. 4 S. R. 1 W. W. M.

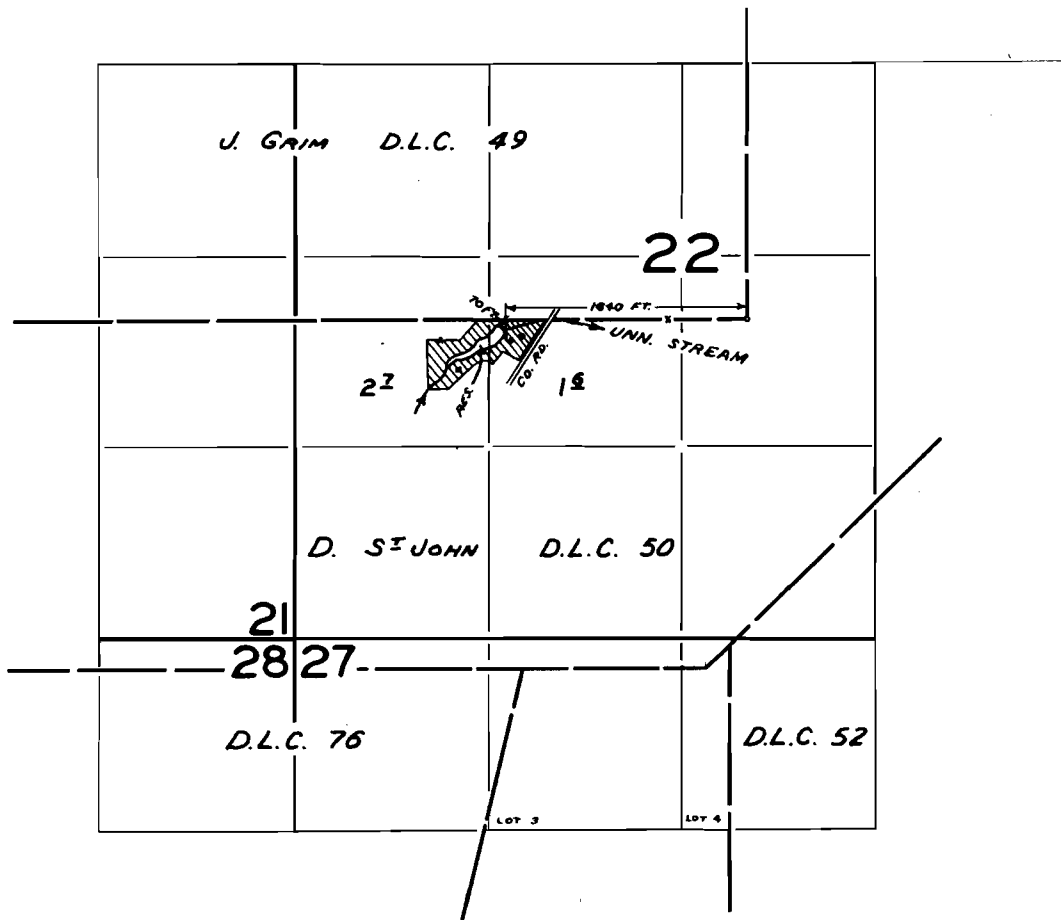

FINAL PROOF SURVEY
UNDER

Application No. R-37291 Permit No. R-2711
37292 27775

IN NAME OF

H. F. PARDEY

Surveyed APR. 15 1965, by C. GARDNER