


# T. 7 S. R. 58 & 6 W. W. M.

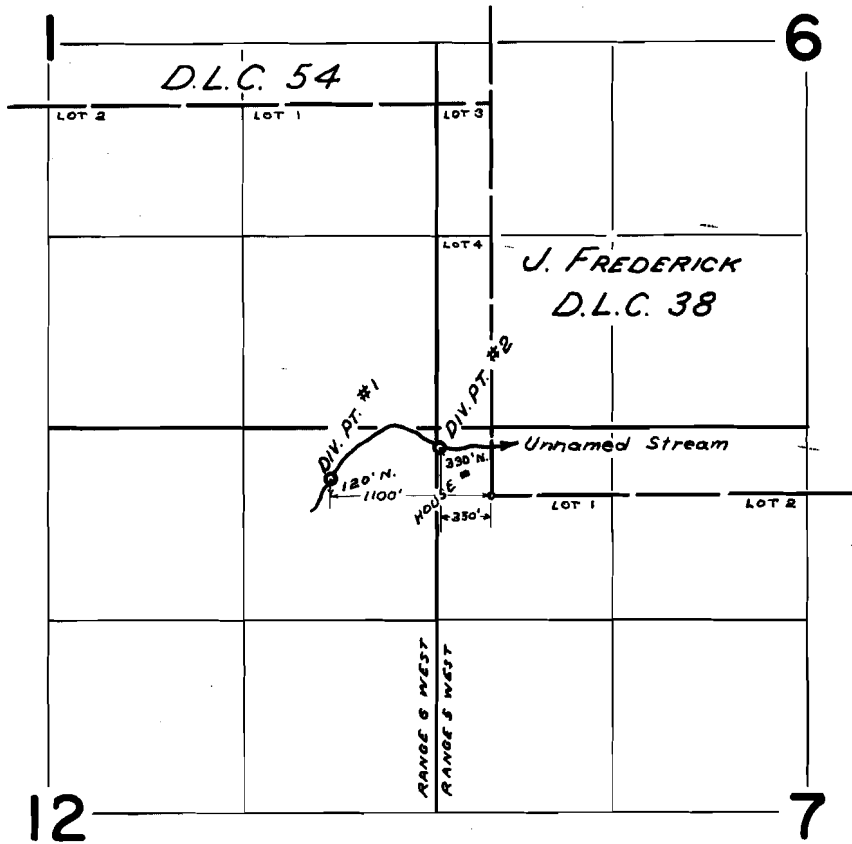

## FINAL PROOF SURVEY UNDER

Application No. 39869 Permit No. 29676  
IN NAME OF

Emily Cooper Philips

Surveyed JUL. 27 1965, by C. GARDNER