


T.8S.R.3W.W.M.

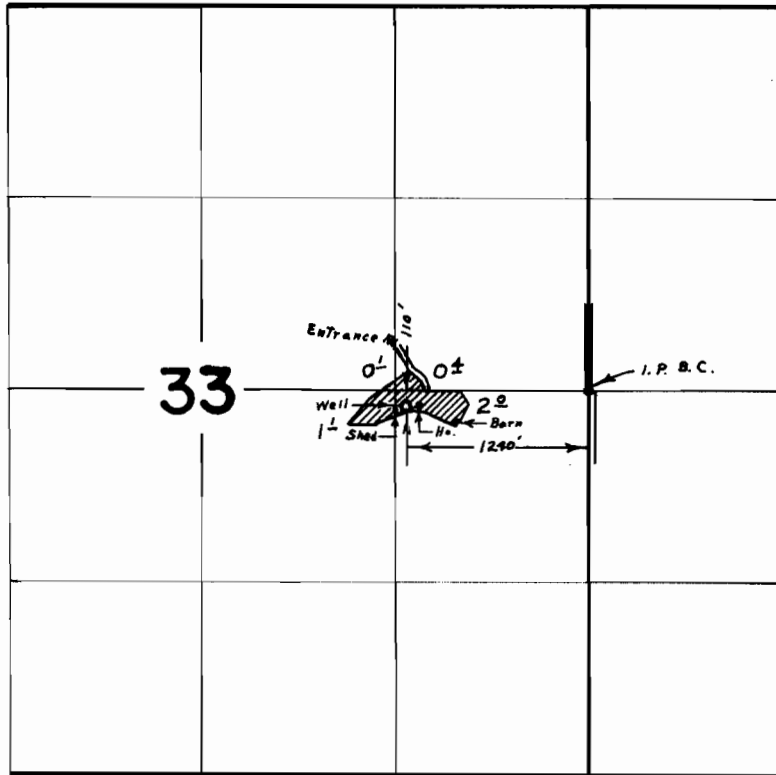

FINAL PROOF SURVEY UNDER

Application No. G-2164 Permit No. G-1996
IN NAME OF

LANDIS J. PHILPOTT

Surveyed Sept. 8, 1966, by L. E. Gould