


T. 4 S. R. 1 W. W. M.

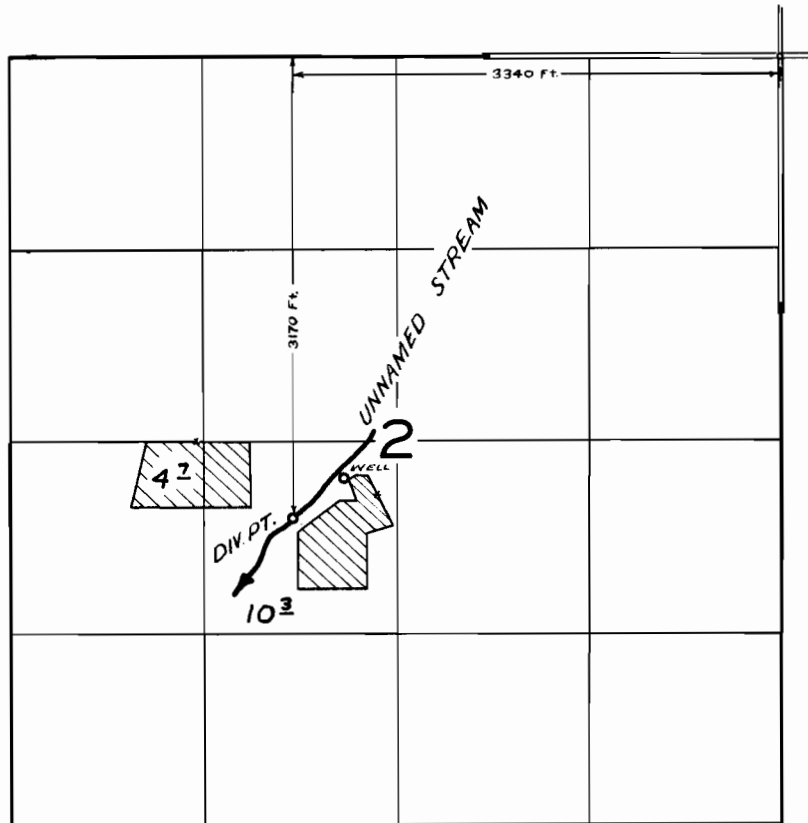

FINAL PROOF SURVEY
UNDER

Application No. 37395 Permit No. 27836
IN NAME OF

CARROLL POOLE

Surveyed APR 14 1965, by C. GARDNER