


T.4S.R.2&3W.W.M.

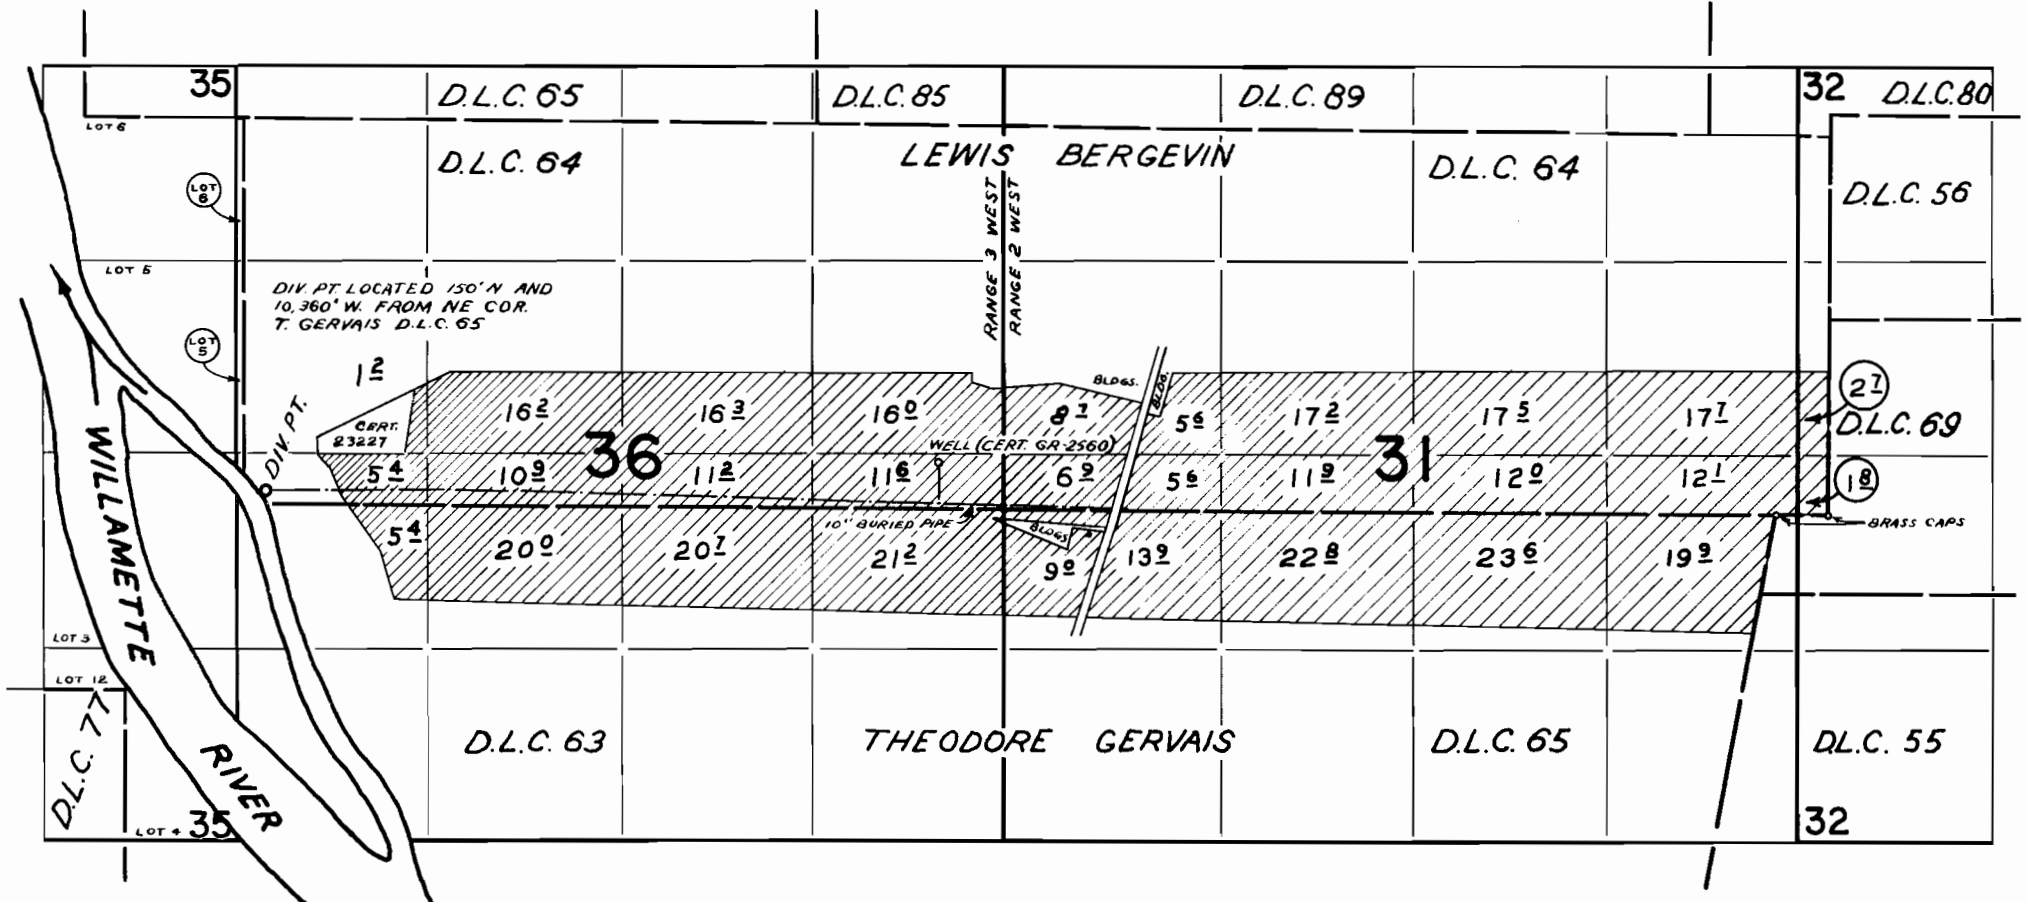

FINAL PROOF SURVEY UNDER

Application No...37155 Permit No... 27675

IN NAME OF

J.W. & HELEN RICHARDSON

Surveyed May 13-14, 1965 by C. Gardner