


# T.9S.R.2W.W.M.

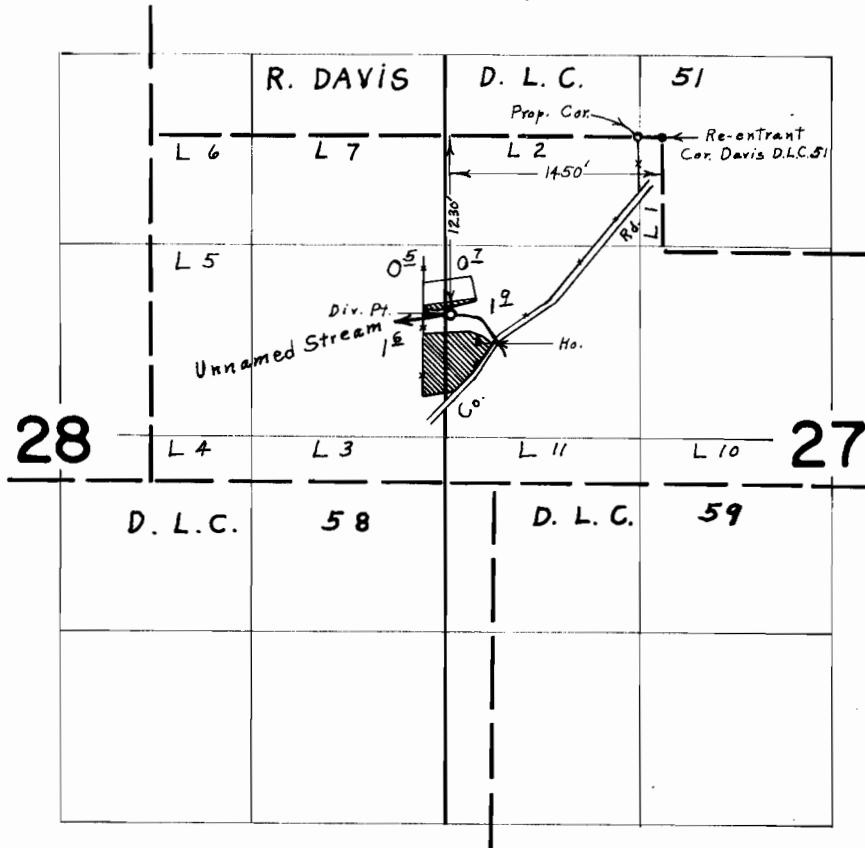

## FINAL PROOF SURVEY UNDER

Application No. 37836... Permit No. 28209...  
IN NAME OF

ARCHIE R. & ALWILDA J. TROUT

Surveyed April 4, 1967, by L. E. Gould...