


T. 9 S. R. 3 W. W.M.

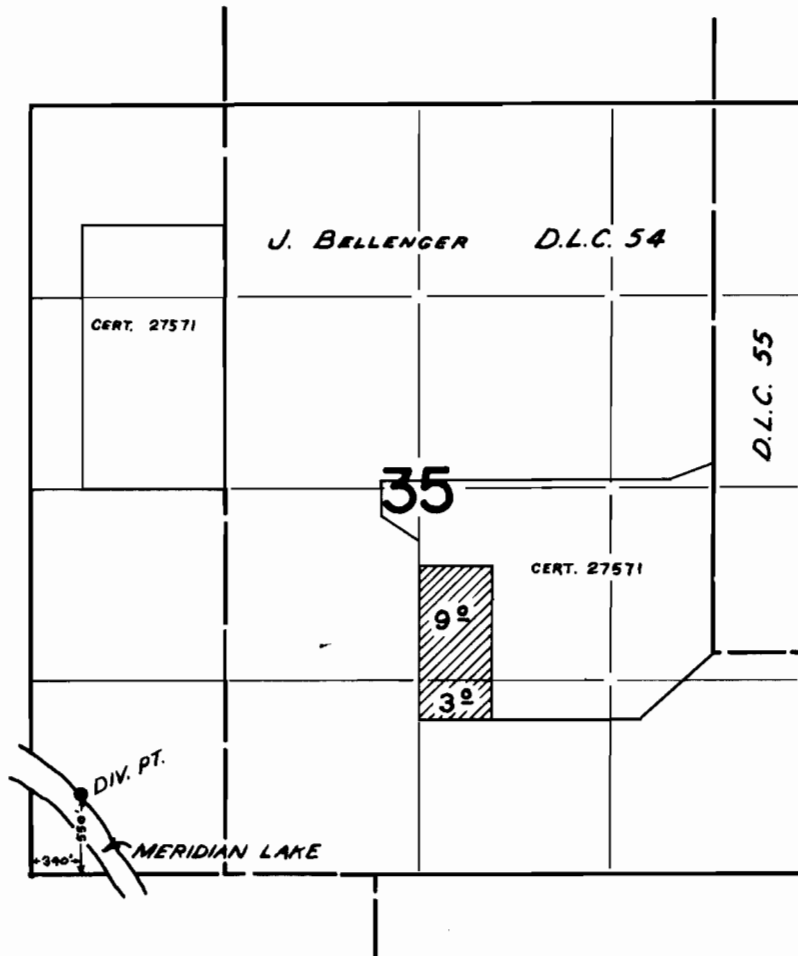

FINAL PROOF SURVEY UNDER

Application No. 39079 Permit No. 29172
IN NAME OF

N. C. White

Surveyed JUN 17 1965, by C. GARDNER