


T. 4S. R. 1 & 2 W. W.M. .

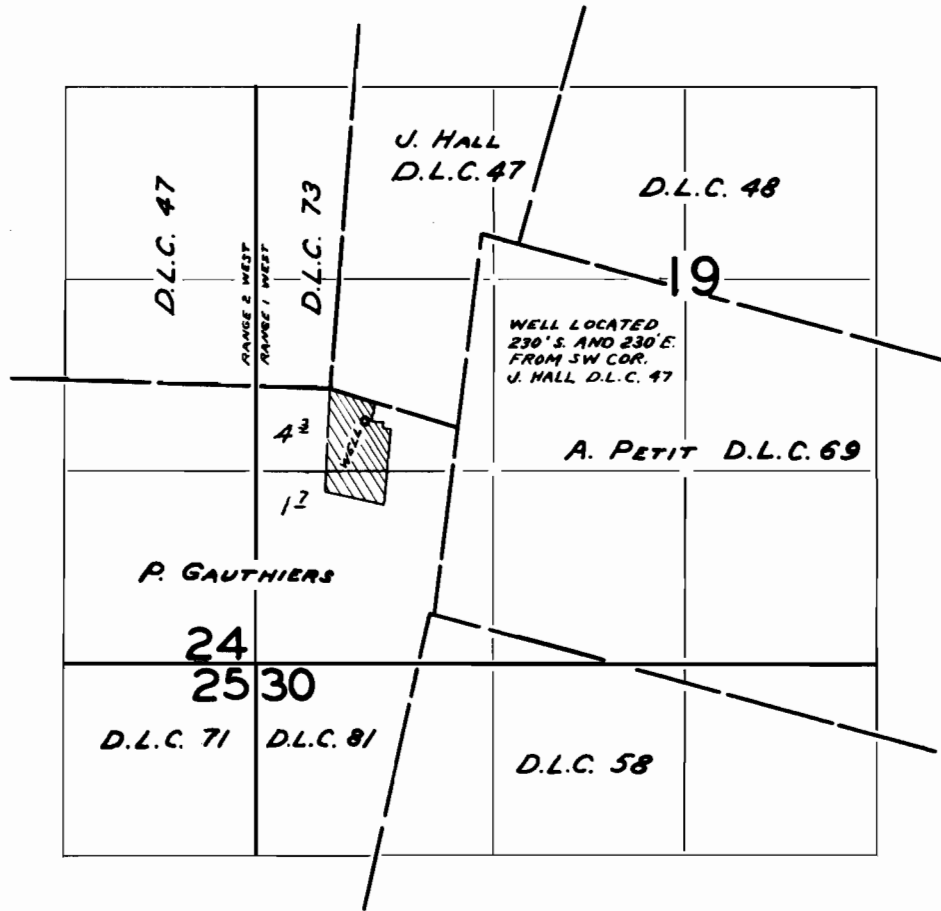

FINAL PROOF SURVEY
UNDER

Application No. G-2409 Permit No. G-2216
IN NAME OF

BEVERLY WILLIAMS

Surveyed APR. 14 1965, by C. GARDNER