


T. 8 S. R. 6 W. W. M.

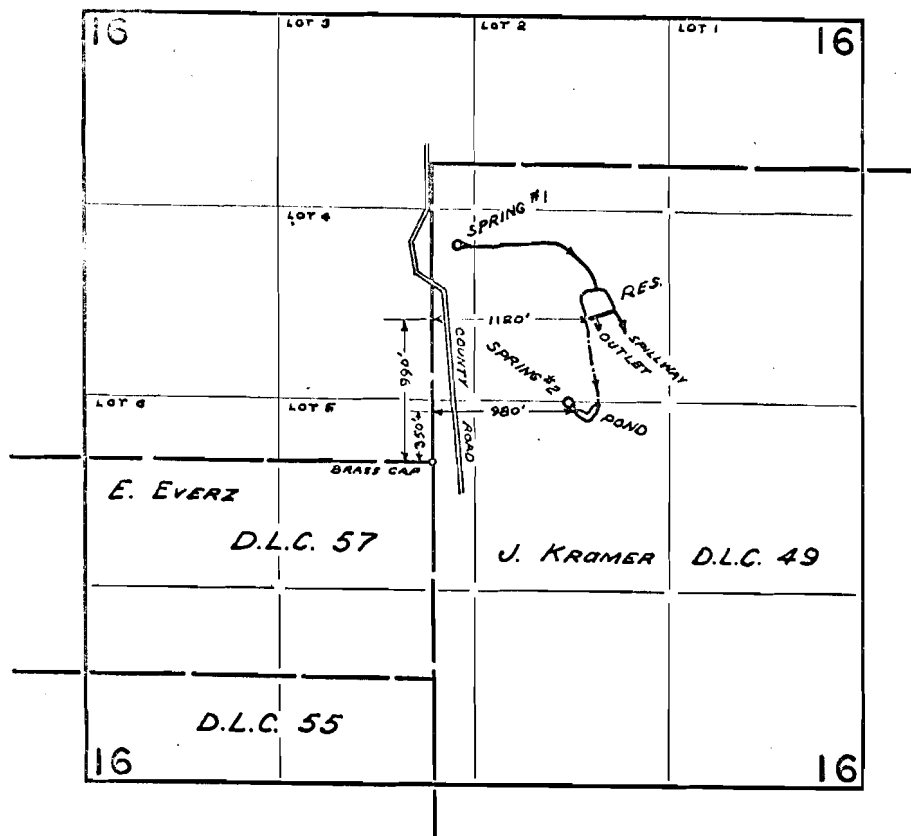

FINAL PROOF SURVEY
UNDER

Application No. R-34454
33769 Permit No. R-2553
27048
IN NAME OF

Herbert Roberts

Surveyed JUL. 29 1965, by C. GARDNER