
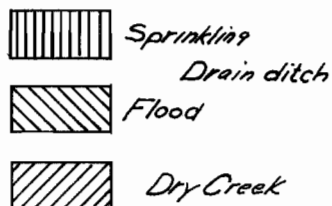


T.2 N. R.42 E.W.M.

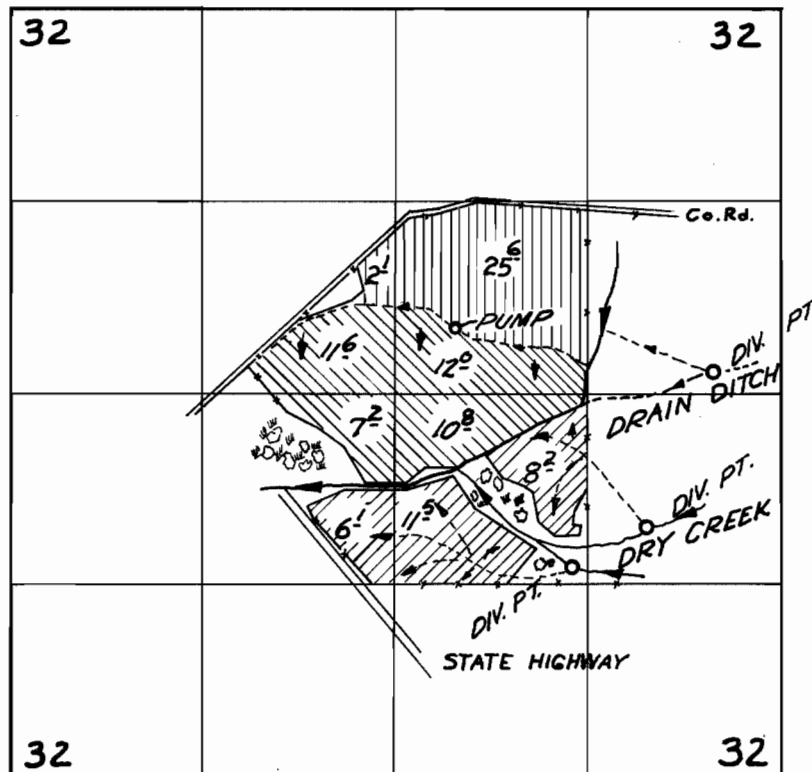

Div. Pts. located 120 ft. N.,
110 ft. W. and 390 ft. N.,
400 ft. E. and 1450 ft. N.,
860 ft. E. ALL from the
S.E. Cor. NW $\frac{1}{4}$, SE $\frac{1}{4}$
of Section 32

FINAL PROOF SURVEY UNDER

Application No. 31850 Permit No. 25201
IN NAME OF

DON MEDLEY

Surveyed June 30 1966, by V. GARNER