


T.3S.

R.13E

W.M.

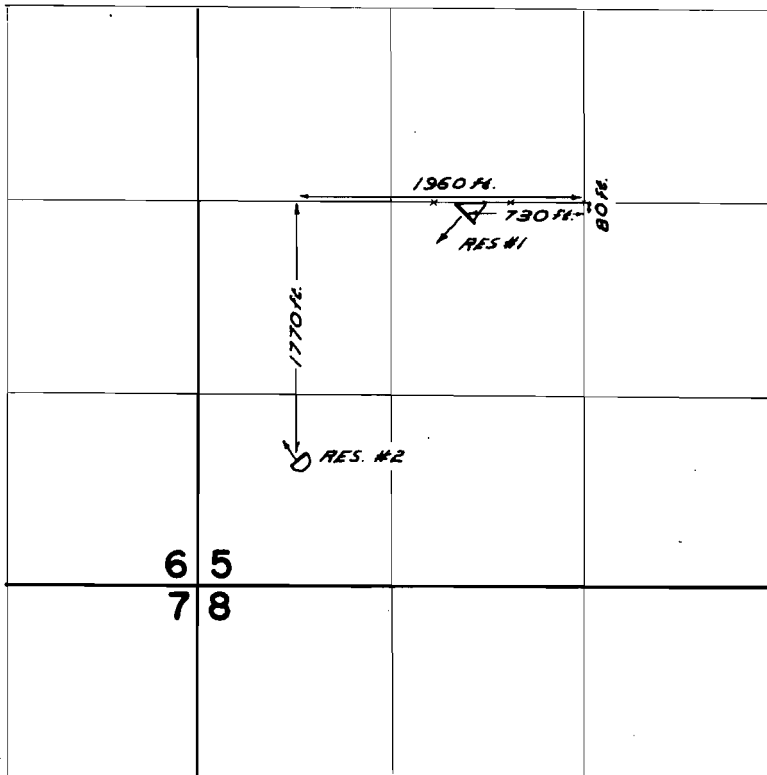

**FINAL PROOF SURVEY**  
UNDER

Application No. R-38322 Permit No. R-3198  
IN NAME OF

H. KENNETH SMITH

Surveyed JUNE 10 1965, by C. GARDNER