


T.2S. R.2W. W.M.

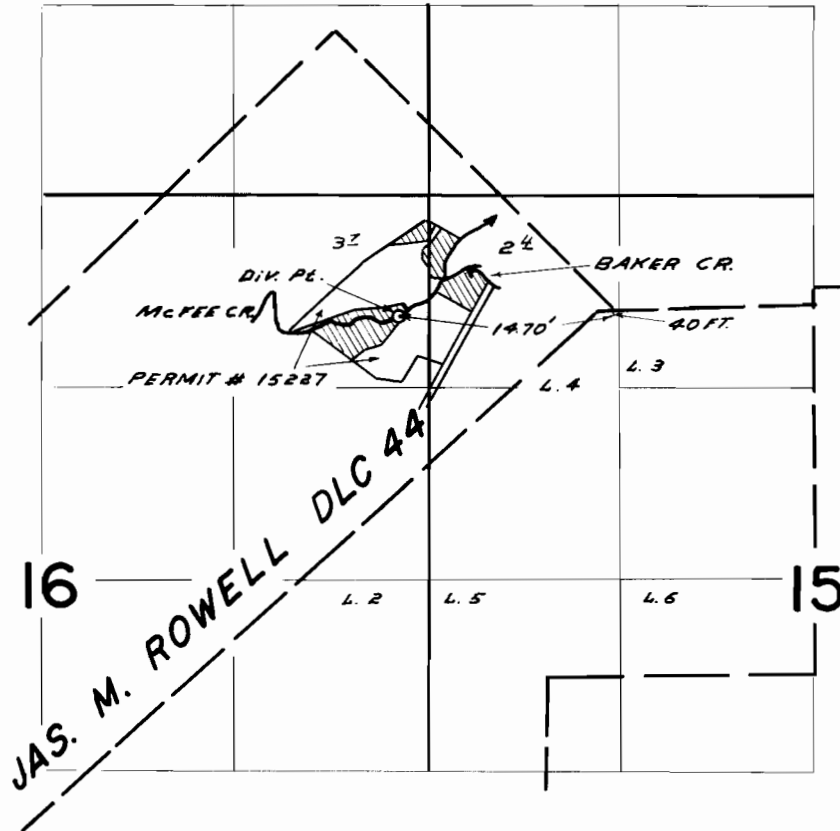

FINAL PROOF SURVEY
UNDER

Application No. **37210** Permit No. **27729**
IN NAME OF

STANFORD A. GOTTER

Surveyed **MAY 3 1965**, by **L. COLEBANK**