


T.4&5S.R.4W.W.M.

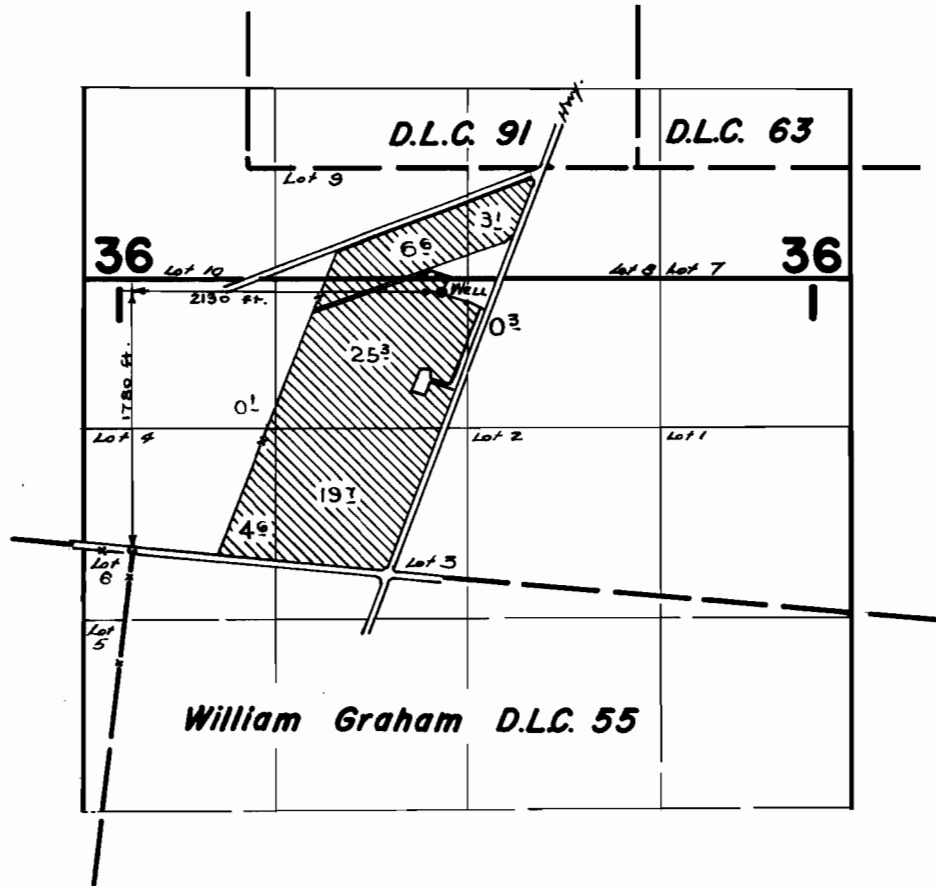

**FINAL PROOF SURVEY**  
UNDER

Application No. ~~G-2628~~ Permit No. ~~G-2435~~  
IN NAME OF

**EARL DAY**

Surveyed *November 2, 1965*, by *A. Jackson*