


# T.5S.R.3W.W.M.

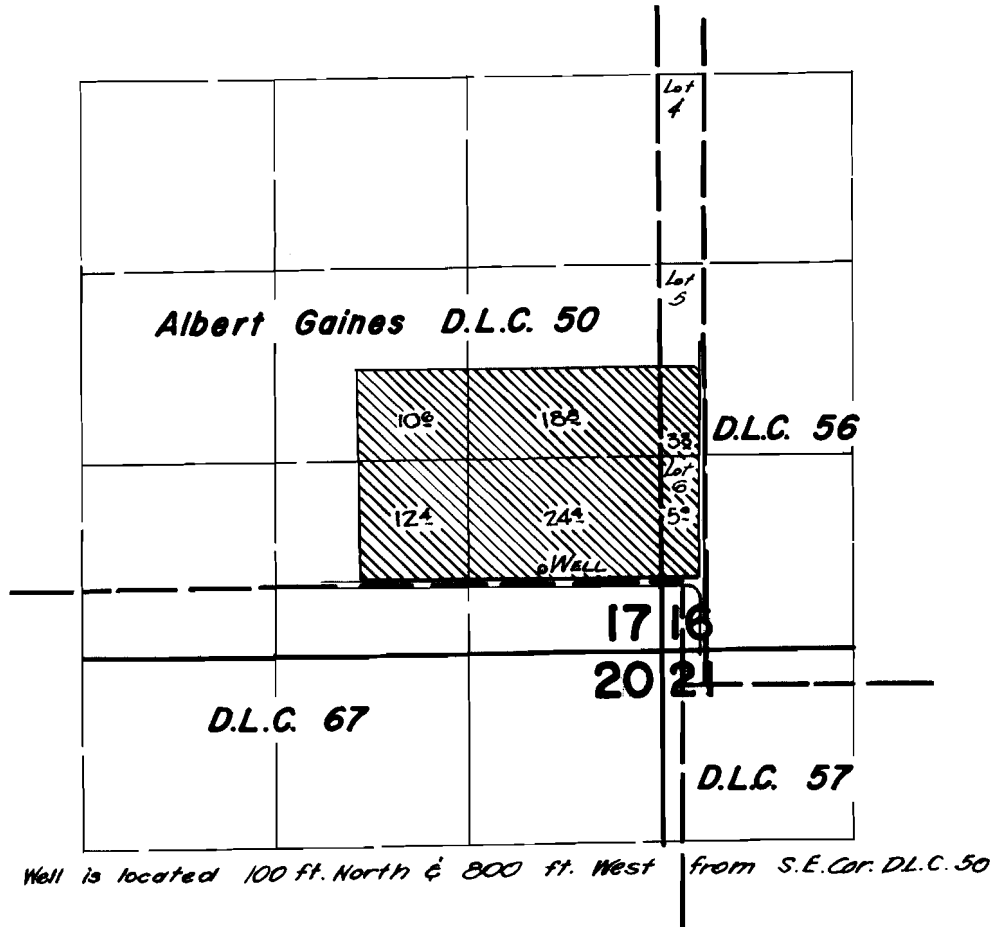

## FINAL PROOF SURVEY UNDER

Application No. G-2949 Permit No. G-2744  
IN NAME OF

JAMES C. SHELBURNE

Surveyed July 28, 1965, by

*R. Jackson*