


T.5S.R.6W.W.M.

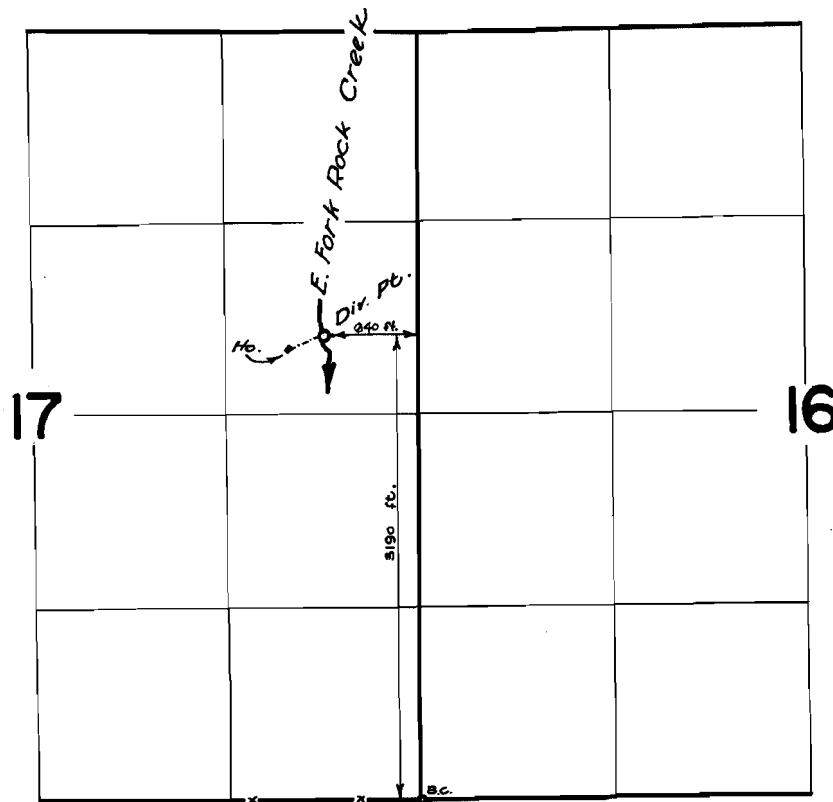

FINAL PROOF SURVEY
UNDER

Application No. 40698 Permit No. 30316
IN NAME OF

LESTER TURNIDGE

Surveyed July 28 1965, by R. Jackson