


T.21S.R.5W.W.M.

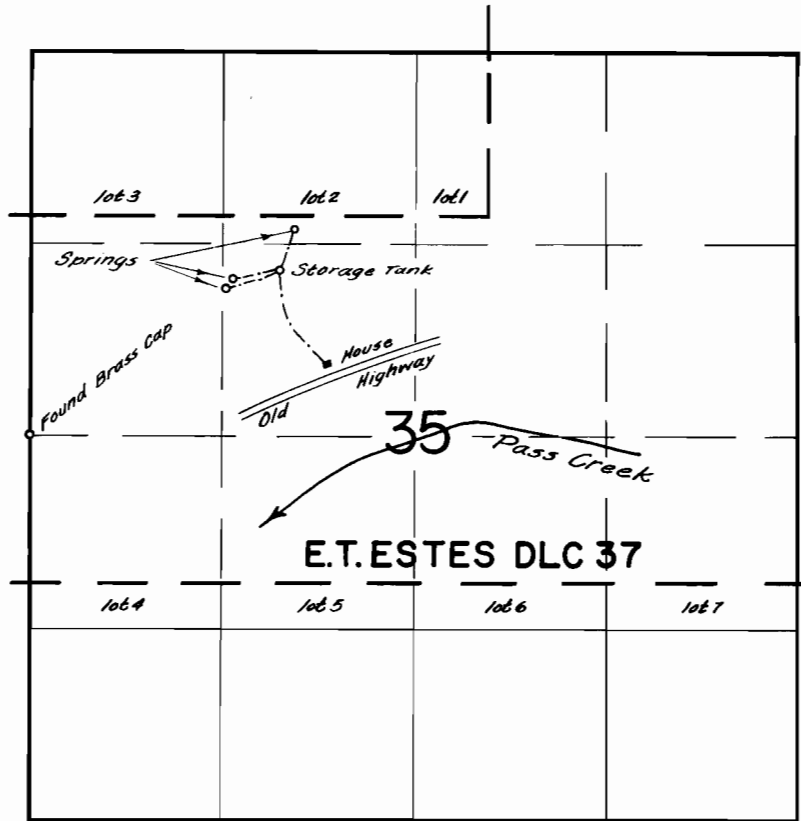

FINAL PROOF SURVEY
UNDER

Application No. 8562 Permit No. 5605
IN NAME OF

J.Q. Carlile

Surveyed March 25 1963, by C.O. Bartels