


# T.I.S.R.4W.W.M.

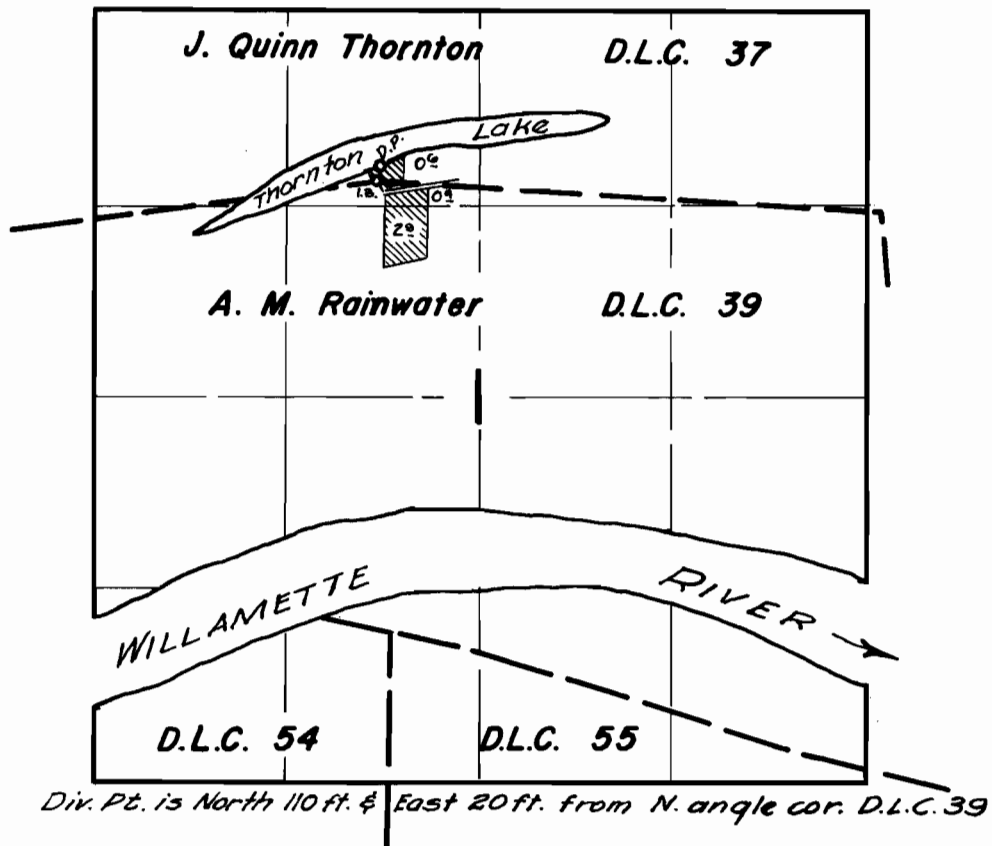

## FINAL PROOF SURVEY UNDER

Application No. **38574** ... Permit No. **28738** ...  
IN NAME OF

**WOODROW WILSON**

Surveyed July 18 1966 by *R. Jackson*