


T.3S.R.4E.W.M.

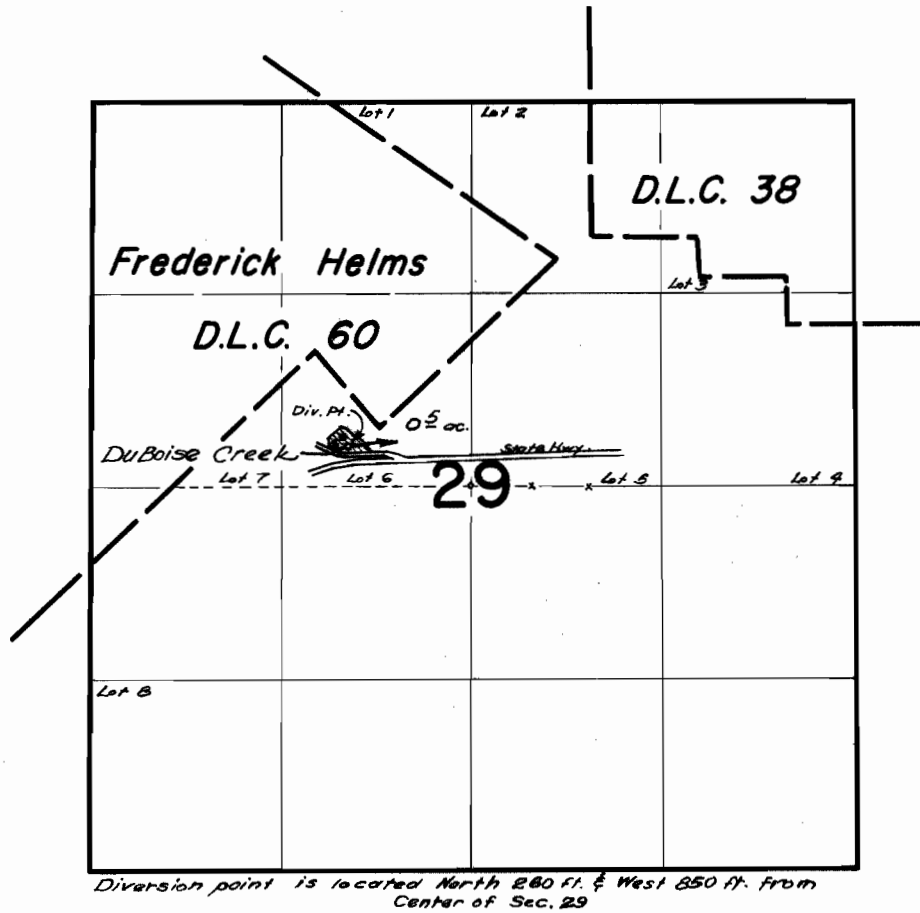

FINAL PROOF SURVEY
UNDER

Application No. 38999... Permit No. 29052..
IN NAME OF

.....ARTHUR T. ALF.....

Surveyed April 20, 1905, by *L. Jackson*