


# T.4S.R.IE.W.M.

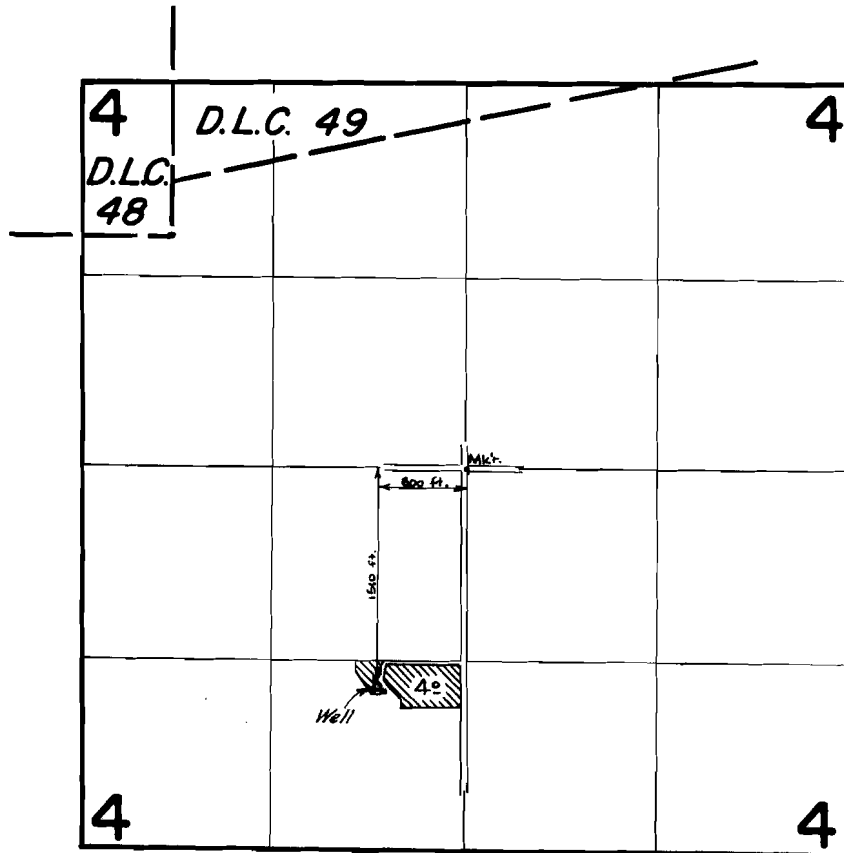

## FINAL PROOF SURVEY UNDER

Application No. G-2928. Permit No. 6-2717...  
IN NAME OF

JOHN WILSON BECK

Surveyed *May 12, 1965*, by *R. Jackson*