


T.3S.R.4E.W.M.

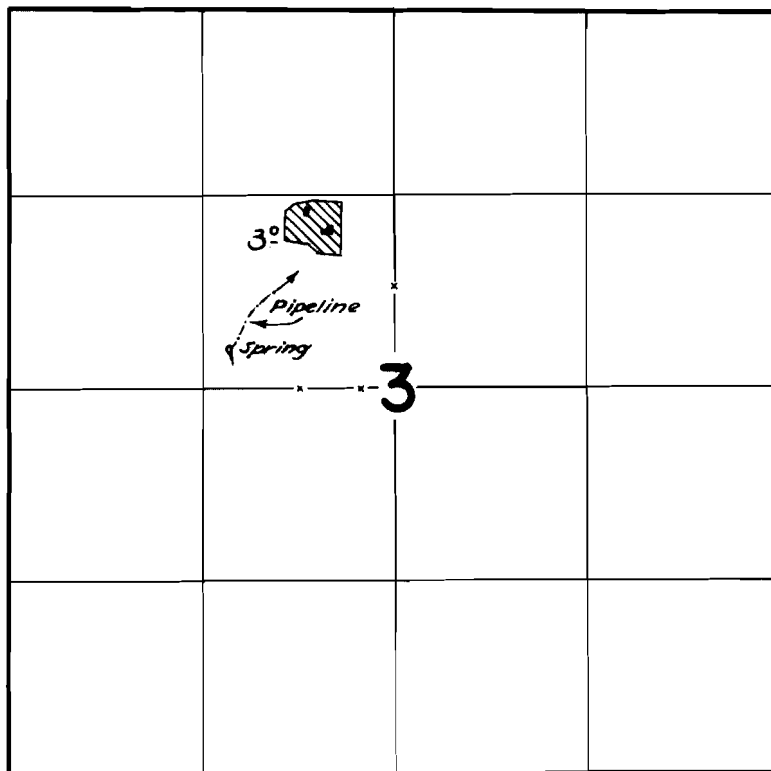


FINAL PROOF SURVEY
UNDER

Application No. 33465... Permit No. 26441...
IN NAME OF

ARNOLD M. BRANDENBERG

Surveyed July 23, 1963, by T. Lauer

T.3S.R.4E.W.M.

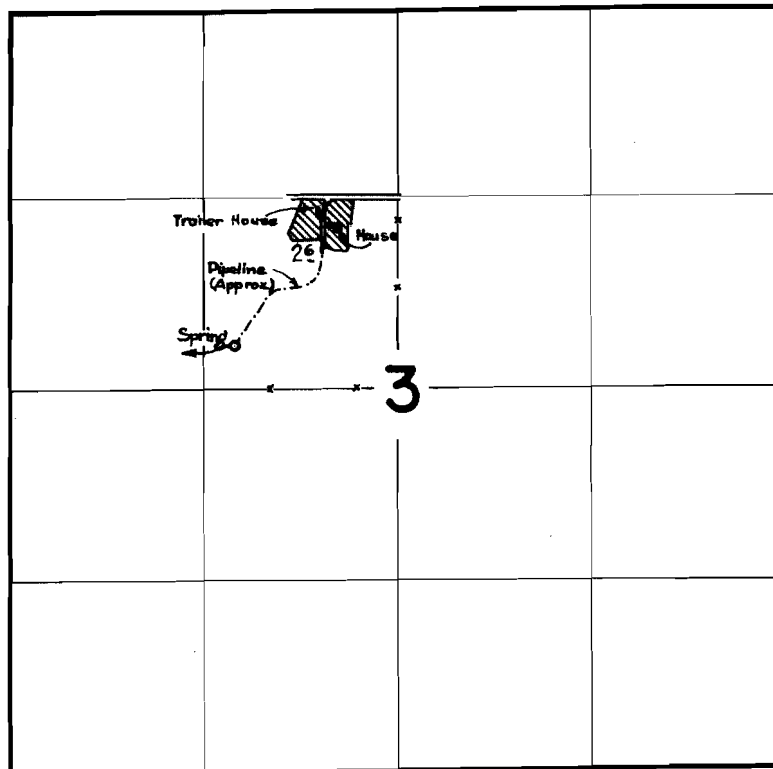

Spr. Located 1110 ft. W. & 300 ft. N. from the Center Sec. 3

FINAL PROOF SURVEY
UNDER

Application No. **33465** Permit No. **26441**
IN NAME OF

ARNOLD M. BRANDENBERG

Surveyed *April 20, 1965*, by

R. Jackson